

MAR 17 2000

LAND CORNER RECORDATION CERTIFICATE
Filing Requirement of Act 74, Mich. P.A. 1970

1091823
LIBER 9268 PAGE 11
12/27/1999 01:15:39 P.M.
MACOMB COUNTY, MI
CARMELLA SABAUGH, REG/DEEDS

SECTION

For corners in

MACOMB
(County)

LENOX TOWNSHIP

Located In: Corner Code #

- 1. Public Land Survey T 4 N 14 E M-10
T R
T R
T R
- 2. Property Controlling S T R
in Section S T R
- 3. Miscellaneous S T R
Property in Sec. S T R

ACCEPTED BY THE MACOMB COUNTY SURVEY PEER GROUP AS THE OFFICIAL CORNER UNDER MICHIGAN PUBLIC ACT 345 OF 1990 AT A MEETING HELD ON 12/15/99
William E. Soderberg
WILLIAM E. SODERBERG, P.S., CHAIRMAN
Register of Deeds Stamp & File Number

- 4. Lot No. _____, Recorded Plat _____
- 5. Private Claims _____


I, ROBERT H. BIRKETT, in a field survey on JUNE 6, 1999 do hereby certify that under requirements of P.A. 74, Michigan P.A. of 1970, the corner points mentioned in lines 1 and 2 above were in conformance with regulations and rules therefore as required in the current manual of survey instructions of the United States Department of the Interior, Bureau of Land Management or by a decree of a Court of Law and/or that the corner points mentioned in lines 3, 4 and 5 above were in conformance with the rules of the Michigan Board of Land Surveyors or by a Decree of a Court of Law; established, re-established, monumented, re-monumented, recovered, found as expressed below:

	A	B	C	D	E	F	G	H	I	J	K	L	M
1													
2	6		5		4		3		2		1		
3													
4	7		8		9		10		11		12		
5													
6	18		17		16		15		14		13		
7													
8	19		20		21		22		23		24		
9													
10	30		29		28		27		26		25		
11													
12	31		32		33		34		35		36		
13													

NOTE: Not more than 2 corners, all in the same town and range, may be recorded on this certificate.

A. Description of original monument and accessories and/or subsequent restoration:
LENOX M-10. 1817 W. PRESTON, GLO, SET WOOD POST

- (a) 1977, H. KOBS # 14097, 1" AXLE SHAFT, SURVEY L. 2923, P. 838 M.C.R.
- (b) 1977, H. AVEY #15396, 1" BAR IN MONUMENT BOX, SURVEY L. 2865, P. 232 M.C.R.
- (c) 1979, R. SMITH #16052, 1" PIN IN MONUMENT BOX, SURVEY L. 3168, P. 952 M.C.R.
- (d) 1989, ST. CLAIR CO. ROAD COM. FIELD NOTES, 1" BAR IN MONUMENT BOX.
- (e) 1996, G. PLATZ #38121, 1" IRON PIPE IN MONUMENT BOX, SURVEY L. 7201, P. 598 M.C.R.
- (f) 1996, D. KING # 30085, 1" AXLE SHAFT IN MONUMENT BOX, SURVEY, L. 7268, P. 956 M.C.R.

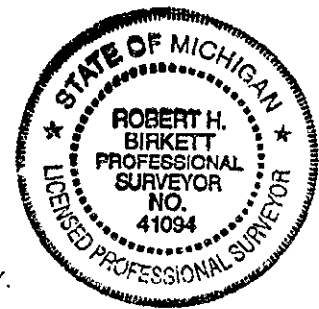

B. Description of corner evidence found and/or method applied in restoring or reestablishing corner:
LENOX M-10. FOUND 1" IRON IN MONUMENT BOX CENTER OF COUNTY LINE ROAD (ASPHALT) 1' DEEP. CORNER COMMON WITH A-10 TOWN 4 NORTH, RANGE 15 EAST, CASCO TOWNSHIP, ST. CLAIR COUNTY.
N.E. - (d 42.83') (e 42.80') - P.K. NAIL IN SOUTH EAST FACE 12" OAK.
N.E. - (e 48.74') - P.K. NAIL WITH TAG IN WEST FACE 18" TREE.
S.W. - (d, e 64.08') - P.K. NAIL WITH TAG ST. CLAIR COUNTY ROAD COMM. IN NORTH EAST FACE 18" BEECH (TAG GROWN OVER).
W. - (e 42.90') - P.K. NAIL IN NORTH EAST FACE 20" OAK

FIELD MEASUREMENTS
M10 TO M-9 GLO (1817) - 40 CHAINS (2640')
H. KOBS (1977) - 2700.80'
G. PLATZ (1996) - 2701.01'
RE-MONUMENTATION (1999) - 2700.90'
M10 TO M-11 GLO (1817) - 40 CHAINS (2640')
D. KING (1999) - 2724.86'
RE-MONUMENTATION (1999) - 2724.83'

C. Description of monument for corner and accessories established to perpetuate locating the position of the corner:
LENOX M-10. SET ON AN EXISTING IRON A 2" DIAMETER ALUMINUM CAP STAMPED "MACOMB COUNTY MONUMENT, MI ACT 345, #41094, M 10" IN EXISTING EXISTING MONUMENT BOX.

- AZ. 55° 42.81' SET REMON TAG ABOVE FOUND P.K. NAIL IN SOUTHEAST FACE 15" MAPLE.
- AZ. 135° 48.84' SET REMON TAG ABOVE FOUND P.K. NAIL WITH ST. CLAIR COUNTY ROAD COMM. TAG IN SOUTHWEST ROOT (TAG GROWN OVER) 18" OAK.
- AZ. 195° 70.33' CENTER TOP NUT HYDRANT
- AZ. 210° 64.09' SET REMON TAG ABOVE FOUND P.K. NAIL W/MACOMB COUNTY ROAD COMM. TAG IN SOUTHEAST FACE (TAG GROWN OVER) 18" MAPLE.
- AZ. 280° 42.88' SET REMON TAG BETWEEN DOUBLE P.K. NAILS IN NORTHEAST FACE 21" OAK.
- AZ. 310° 59.94' PLACED REMON TAG ON FOUND P.K. NAIL NORTH END 18" CMP @ DRIVE HOUSE # 5236.

THE SELECTED LOCATION IS ACCEPTED BY ME AND IS GENERALLY ACCEPTED BY PROFESSIONAL SURVEYORS AS THE BEST AVAILABLE EVIDENCE OF THE POSITION OF THE ORIGINAL CORNER.

Signed by Robert H. Birkett Date NOVEMBER 23, 1999
Surveyor's Michigan License No. 41094

049