

LAND CORNER RECORDATION CERTIFICATE  
 Filing Requirement of Act 74, Mich. P.A. 1970

For corners in

<u>Macomb</u> (County)	Located in: Bruce Township	Corner Code #
1. Public Land Survey	T <u>5N</u> R <u>12E</u>	<u>C-13</u>
	T ___ R ___	_____
	T ___ R ___	_____
	T ___ R ___	_____
2. Property Controlling in Section	S ___ T ___ R ___	_____
	S ___ T ___ R ___	_____
3. Miscellaneous Property in Sec.	S ___ T ___ R ___	_____
	S ___ T ___ R ___	_____

SURVEY &  
 REMONUMENTATION

APR 07 1998

SECTION

Register of Deeds Stamp & File Number

4. Lot No. \_\_\_\_\_, Recorded Plat \_\_\_\_\_  
 5. Private Claims \_\_\_\_\_

I, Huston K. Kennedy, in a field survey on 4/23, 19 97 do hereby state that under requirements of P.A. 74, Michigan P.A. of 1970, the corner points mentioned in lines 1 and 2 above were in conformance with regulations and rules therefore as required in the current manual of survey instructions of the United States Department of the Interior, Bureau of Land Management or by a decree of a Court of Law and /or that the corner points mentioned in lines 3, 4 and 5 above were in conformance with the rules of the Michigan Board of Land Surveyors or by a Decree of a Court of Law, established, re-established, monumented, recovered, found as expressed below.

NOTE: Not more than 2 corners, all in the same town and range, may be recorded on this certificate.

A	B	C	D	E	F	G	H	I	J	K	L	N
1												
2	6	5	4	3	2	1						
3												
4	7	8	9	10	11	12						
5												
6	18	17	16	15	14	13						
7												
8	19	20	21	22	23	24						
9												
10	30	29	28	27	26	25						
11												
12	31	32	33	34	35	36						
13												

- A. Description of original monument and accessories and/or subsequent restoration:  
 1817-GLO Wampler, D.S.; Set Post 36" Pine N28°E 98 Links; 12" White Oak S33°W 91 Links  
 1.) 1977-Kobs, PS #14097; LCRC L.2775, Pg.800 - Fnd 3/8" Pipe  
 2.) 1995-King, PS #30085; LCRC L.6586, Pg.180 - Fnd 3/8" Pipe  
 3.) 1977-Kobs, PS #14097; Survey L.2775, Pg.783 - Fnd 3/8" Iron Pipe, used same wit as 1977 LCRC  
 4.) 1978-Kobs, PS #14097; Survey L.3021, Pg.144 - Fnd 3/8" Iron Pipe, used same wit as 1977 LCRC  
 5.) 1980-Kobs, PS #14097; Survey L.3287, Pg.525 - Fnd 3/8" Iron Pipe, used same wit as 1977 LCRC  
 6.) 1984-Kobs, PS #14097; Survey L.3705, Pg.126 - Fnd 3/8" Iron Pipe, used same wit as 1977 LCRC  
 7.) 1986-King, PS #30085; Survey L.3880, Pg.108 - Fnd 3/8" Iron Pipe, used same wit as 1977 LCRC  
 8.) 1986-Kobs, PS #14097; Survey L.4077, Pg.588 - Fnd 3/8" Iron Pipe, used same wit as 1977 LCRC  
 9.) 1986-King, PS #30085; Survey L.4151, Pg.98 - Fnd 3/8" Iron Pipe, used same wit as 1977 LCRC (over)

- B. Description of corner evidence found and/or method applied in restoring or reestablishing corner:  
 1997 Kennedy Surveying, Inc. - Kennedy, PS #17623 - Fnd 3/8" Iron Pipe 2.75 feet North of the existing centerline of 32 Mile Road extending to the East & West, which has a bituminous surface. A tree row extending to the North. Found 1/2" Iron Rod 133.52 feet to the East, which is being used and accepted as a common corner to Sectionw 5 & 6, T4N, R12E, Washington Twp., (C-1).

Witnesses from LCRC #2 were used to recover and verify the location of the found 3/8" Iron Pipe.

See back side of LCRC for Field Measurements


ACCEPTED BY THE MACOMB COUNTY SURVEY REEF  
 GROUP AS THE OFFICIAL CORNER UNDER MICHIGAN  
 PUBLIC ACT 345 OF 1990 AT A MEETING HELD  
 ON July 10, 1997  
William E. Soderberg  
 WILLIAM E. SODERBERG, P.S., CHAIRMAN

- C. Description of monument for corner and accessories established to perpetuate locating the position of the corner:  
 C-13 I replaced the found 3/8" Iron Pipe with a 3/4" x 24" Iron Rod w/2" diameter aluminum cap stamped "Macomb County Monument MI Act 345" #17623 in a new Monument Box  
 Due North 136.66 Set PK & Remon Washer East face Power Pole  
 S63°E 140.40' Set PK & Remon Washer NE face 13" Maple  
 S03°W 77.80' NE corner of house #3924  
 S38°W 45.20' Set PK & Remon Washer NE face 9" Apple  
 East 133.52 feet, corner common to Sections 5 & 6, T4N, R12E, Washington Twp., (C-1)

The selected location is accepted by me and is generally accepted by Professional Surveyors as the best available evidence of the position of the original corner.

Signed by Huston K. Kennedy  
 Surveyor's Michigan License No. 176230

Date 7-10-97

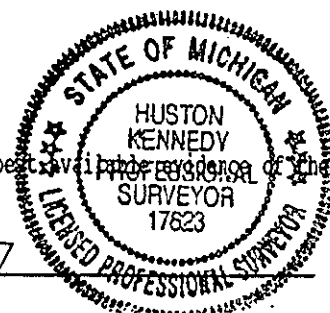

759

C0561140 LIBER:07589 PAGE:441 09:21A 08/13/1997  
CARMELLA SABAUGH-MACOMB COUNTY, MI REG/DEEDS

- 10.) 1990-King, PS #30085; Survey L.4866, Pg.825 - Fnd 3/8" Iron Pipe, used same wit as 1977 LCRC  
11.) 1993-King, PS #30085; Survey L.5969, Pg.174 - Fnd 3/8" Iron Pipe, used same wit as 1977 LCRC

FIELD MEASUREMENTS BETWEEN

C-13 to B-13

GLO = 40 chains or 2640.00 Ft.  
GRID-MEA = 2646.91 Ft.

C-13 to C-1

GLO = 1.90 chains or 125.40 Ft.  
GROUND-MEA = 133.52 Ft.

C-13 to D-13

GLO = 40 chains or 2640.00 Ft.  
GRID-MEA = 2657.24 Ft.