

LAND CORNER RECORDATION CERTIFICATE
 Filing Requirement of Act 74, Mich. P.A. 1970

For corners in

Macomb (County)	Located In: Bruce Township	Corner Code #
1. Public Land Survey	T 5N R 12E	D-13
	T R	
	T R	
	T R	
2. Property Controlling in Section	S T R	
	S T R	
3. Miscellaneous Property in Sec.	S T R	
	S T R	

SURVEY &
 REMONUMENTATION

APR 07 1998

SECTION

Register of Deeds Stamp & File Number

4. Lot No. _____, Recorded Plat _____
 5. Private Claims _____

I, Huston K. Kennedy, in a field survey on 4/17, 1997 do hereby state that under requirements of P.A. 74, Michigan P.A. of 1970, the corner points mentioned in lines 1 and 2 above were in conformance with regulations and rules therefore as required in the current manual of survey instructions of the United States Department of the Interior, Bureau of Land Management or by a decree of a Court of Law and/or that the corner points mentioned in lines 3, 4 and 5 above were in conformance with the rules of the Michigan Board of Land Surveyors or by a Decree of a Court of Law; established, re-established, monumented, recovered, found as expressed below:

NOTE: Not more than 2 corners, all in the same town and range, may be recorded on this certificate.

	A	B	C	D	E	F	G	H	I	J	K	L	M
1													
2		6		5		4		3		2		1	
3													
4		7		8		9		10		11		12	
5													
6		10		17		16		15		14		13	
7													
8		19		20		21		22		23		24	
9													
10		30		29		28		27		26		25	
11													
12		31		32		33		34		35		36	
13													

A. Description of original monument and accessories and/or subsequent restoration:

- 1817-GLO Wampler, D.S.; Set Post 12" White Oak N17°E 32 Links; 12" White Oak S16°E 76 Links
- 1.) 1978-Kobs, PS #14097; LCRC L.2923, Pg.881 - Fnd 1/2" Iron Bar
- 2.) 1980-Penn, PS #23505; LCRC L.3205, Pg.650 - Fnd 1/2" Re-rod
- 3.) 1978-Kobs, PS #14097; Survey L.2923, Pg.83 - Fnd 1/2" Iron Bar, used same wit as 1978 LCRC
- 4.) 1979-Penn, PS #23505; Unrecorded Survey - Object found not stated, no witnesses
- 5.) 1979-Penn, PS #23505; Unrecorded Survey - Fnd Iron
- 6.) 1988-Kobs, PS #14097; Unrecorded Survey - Fnd 1/2" Iron Bar
- 7.) 1992-King, PS #30085; Unrecorded Survey - Fnd 1/2" Iron Bar, used same wit as 1988 Unrecorded Survey
- 8.) 1993-Avey, PS #30076; Unrecorded Survey - Fnd 1/2" Bar, used same wit as 1980 LCRC

B. Description of corner evidence found and/or method applied in restoring or reestablishing corner:

1997 Kennedy Surveying, Inc. - Kennedy, PS #17623 - Fnd 1/2" Iron Rod 6" below the surface and 1 foot South of the existing centerline of 32 Mile Road extending to the East & West, which has a bituminous surface. A tree row extending to the North. It is East of driveway for house #4801. I found a 1/2" Iron Rod 191.28 feet to the East which is being used and accepted for the North 1/4 corner of Section 5, T4N, R12E, Washington Twp., (D-1).

Witnesses from LCRC #1 & 2 were used to recover and verify the location of the found 1/2" Iron Rod.

See back side of LCRC for Field Measurements

ACCEPTED BY THE MACOMB COUNTY SURVEY GROUP AS THE OFFICIAL CORNER UNDER MICHIGAN PUBLIC ACT 345 OF 1990 AT A MEETING ON July 10, 1997

William E. Soderberg
 WILLIAM E. SODERBERG, P.S., CHAIRMAN


C. Description of monument for corner and accessories established to perpetuate locating the position of the corner:

D-13 I replaced the found 1/2" Iron Rod with a 3/4" x 24" Iron Rod w/2" diameter aluminum cap stamped "Macomb County Monument MI Act 345" #17623 in a new Monument Box
 Due North 46.75' Set PK & Remon Washer West face Power Pole North 33.11 feet found 1/2" Iron Rod
 N51°W 58.42' Set PK & Remon Washer SW face 26" Oak
 S46°E 76.58' Set PK & Remon Washer NE face Power Pole
 S77°W 155.60' Set PK & Remon Washer NW face 43" Oak
 East 191.28 feet, North 1/4 corner Section 5, T4N, R12E, Washington Twp., (D-1)

The selected location is accepted by me and is generally accepted by Professional Surveyors as the best available evidence of the position of the original corner.

Signed by Huston K. Kennedy
 Surveyor's Michigan License No. 17623

Date 7-14-97

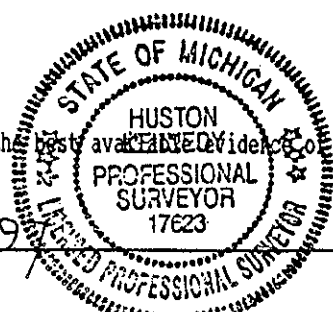

760

C0561141 LIBER:07589 PAGE:443 09:21A 08/13/1997
CARMELLA SABAUGH-MACOMB COUNTY, MI REG/DEEDS

FIELD MEASUREMENTS BETWEEN

D-13 to C-13

GLO = 40 chains or 2640.00 Ft.
GRID-MEA = 2657.24 Ft.

D-13 to D-1

No GLO
GROUND-MEA = 191.28 Ft.

D-13 to E-13

GLO corner falls in lake
Unrecorded Survey by Fenn & Associates dated 5/2/79 = 2643.62 Ft.
Calculated 2643.46 Ft.
GRID-MEA = D-13 to reference for E-13 = 1784.95 Ft.