

**SURVEY & REMONUMENTATION**

APR 29 1996

C0283933 LIBER:06842 PAGE:104 01:43P 12/07/1995  
 CARMELLA SABAUGH-MACOMB COUNTY, MI REG/DEEDS

**COMMISSION**

**LAND CORNER RECORDATION CERTIFICATE**

Filing Requirement of Act 74, Mich. P.A. 1970

For corners in Macomb  
 (County)

Located In: Bruce Twp. Corner Code #

- |                                      |   |           |   |            |            |
|--------------------------------------|---|-----------|---|------------|------------|
| 1. Public Land Survey                | T | <u>5N</u> | R | <u>12E</u> | <u>J-9</u> |
|                                      | T | _____     | R | _____      | _____      |
|                                      | T | _____     | R | _____      | _____      |
|                                      | T | _____     | R | _____      | _____      |
| 2. Property Controlling in Section   | S | _____     | T | _____      | R          |
|                                      | S | _____     | T | _____      | R          |
| 3. Miscellaneous Property in Section | S | _____     | T | _____      | R          |
|                                      | S | _____     | T | _____      | R          |

Register of Deeds Stamp & File Number

4. Lot No. \_\_\_\_\_, Recorded Plat \_\_\_\_\_  
 5. Private Claims \_\_\_\_\_

	A	B	C	D	E	F	G	H	I	J	K	L	M
2	6		5		4		3		2		1		
3													
4	7		8		9		10		11		12		
5													
6	18		17		16		15		14		13		
7													
8	19		20		21		22		23		24		
9													
10	30		29		28		27		26		25		
11													
12	31		32		33		34		35		36		
13													

I, Huston K. Kennedy, in a field survey on November 10, 19 95, do hereby certify that under requirements of P.A. 74, Michigan P.A. of 1970, the corner points mentioned in lines 1 and 2 above were in conformance with regulations and rules therefore as required in the current manual of survey instructions of the United States Department of the Interior, Bureau of Land Management or by a decree of a Court of Law and/or that the corner points mentioned in lines 3, 4 and 5 above were in conformance with the rules of the Michigan Board of Professional Surveyors or by a Decree of a Court of Law; established, re-established, monumented, re-monumented, recovered, found as expressed below:

**NOTE: Not more than 4 corners, all in the same town and range, may be recorded on this certificate.**


- A. Description of original monument and accessories and/or subsequent restoration:  
 1817-GLO Wampler, D.S.; Set Post 40" White Oak S10°E 19 Links; 10" Ironwood N37°W 40 Links  
 1.) 1980-Miller, PS #13589; LCRC L.3288, Pg.536 - Fnd 1/2" Iron Pin  
 2.) 1984-Kobs, PS #14097; LCRC L.3705, Pg.141 - Fnd 1/2" Iron Bar  
 3.) 1988-Avey, PS #15396; LCRC L.4353, Pg.436 - Fnd 1/2" Bar  
 4.) 1990-Ward, PS #22445; LCRC L.4853, Pg.493 - Fnd Iron Rod  
 5.) 1991-King, PS #30085; LCRC L.5253, Pg.204 - Fnd 1/2" Iron Bar  
 6.) 1993-King, PS #30085; Survey L.5831, Pg.266 - Fnd 1/2" Iron  
 7.) Macomb County Road Commission - Unrecorded Witnesses

- B. Description of corner evidence found and/or method applied in restoring or reestablishing corner:  
 1995 Kennedy Surveying, Inc. - Kennedy, PS #17623 - Fnd 1/2" Iron w/cap #30085 1 foot North of the centerline of 34 Mile Road, which has a gravel surface extending to the East & West. A tree-fence row extending to the North, and 45 feet West of the centerline of driveway to house #12600.

Witnesses from LCRC #4 & 5 were used to recover and verify the location of the found 1/2" Iron w/cap #30085.

**FIELD MEASUREMENTS BETWEEN**


J-9 to I-9 2621.18 Ft., GLO = 40.03 chains or 2641.98 Ft.  
 J-9 to K-9 2694.53 Ft., GLO = 40.03 chains or 2641.98 Ft.

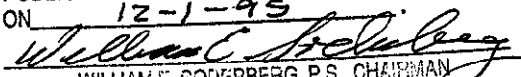ACCEPTED BY THE MACOMB COUNTY SURVEY PEER GROUP AS THE OFFICIAL CORNER UNDER MICHIGAN PUBLIC ACT 345 OF 1990 AT A MEETING HELD ON 12-1-95  
  
 WILLIAM E. GODERBERG, P.S., CHAIRMAN

- C. Description of monument for corner and accessories established to perpetuate locating the position of the corner:  
 J-9 I replaced the found 1/2" Iron with a 3/4" x 24" Iron Rod w/2" diameter aluminum cap stamped "Macomb County Monument MI Act 345 #17623"  
 N03°W 21.97' Set PK & Remon. Washer East face Power Pole  
 S68°W 110.30' Set PK & Remon. Washer NW face 10" Ash  
 Due South 57.19' Set PK & Remon. Washer East face Power Pole  
 S57°E 73.00' Set PK & Remon. Washer NE face 13" Elm

The selected location is accepted by me and is generally accepted by Professional Surveyors as the best available evidence of the position of the original corner.

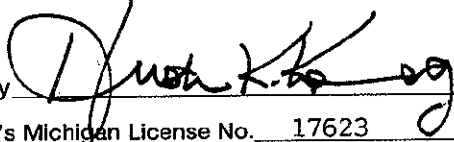

Signed by   
 Surveyor's Michigan License No. 17623

Date December 4, 1995