

APR 29 1996

**COMMISSION**

C0283937 LIBER:06842 PAGE:108 01:43P 12/07/1995  
CARMELLA SABAUGH-MACOMB COUNTY, MI REG/DEEDS

**LAND CORNER RECORDATION CERTIFICATE**

Filing Requirement of Act 74, Mich. P.A. 1970

For corners in  
Macomb

(County)

Located in: Bruce Twp. Corner Code #

- 1. Public Land Survey T 5N R 12E K-11  
T \_\_\_\_\_ R \_\_\_\_\_  
T \_\_\_\_\_ R \_\_\_\_\_  
T \_\_\_\_\_ R \_\_\_\_\_
- 2. Property Controlling S \_\_\_\_\_ T \_\_\_\_\_ R \_\_\_\_\_  
in Section S \_\_\_\_\_ T \_\_\_\_\_ R \_\_\_\_\_
- 3. Miscellaneous S \_\_\_\_\_ T \_\_\_\_\_ R \_\_\_\_\_  
Property in Section S \_\_\_\_\_ T \_\_\_\_\_ R \_\_\_\_\_

Register of Deeds Stamp & File Number

- 4. Lot No. \_\_\_\_\_, Recorded Plat \_\_\_\_\_
- 5. Private Claims \_\_\_\_\_

I, Huston K. Kennedy, in a field survey on November 10, 19 95, do hereby certify that under requirements of P.A. 74, Michigan P.A. of 1970, the corner points mentioned in lines 1 and 2 above were in conformance with regulations and rules therefore as required in the current manual of survey instructions of the United States Department of the Interior, Bureau of Land Management or by a decree of a Court of Law and/or that the corner points mentioned in lines 3, 4 and 5 above were in conformance with the rules of the Michigan Board of Professional Surveyors or by a Decree of a Court of Law; established, re-established, monumented, re-monumented, recovered, found as expressed below:

**NOTE: Not more than 4 corners, all in the same town and range, may be recorded on this certificate.**

**A. Description of original monument and accessories and/or subsequent restoration:**

- 1817-GLO Wampler, D.S.; Set Post 8" Birch N59°W 30 Links; 6" Birch S48°E 10 Links
- 1.) 1980-Coulter, PS #14760; LCRC L.3230, Pg.836 - Fnd 1/2" Steel Rod
- 2.) 1986-Kobs, PS #14097; LCRC L.4077, Pg.539 - Fnd 1/2" Iron Bar
- 3.) 1970-Melching & Associates - Unrecorded Witnesses - Fnd 1/2" Re-rod

ACCEPTED BY THE MACOMB COUNTY SURVEY PEER GROUP AS THE OFFICIAL CORNER UNDER MICHIGAN PUBLIC ACT 345 OF 1990 AT A MEETING HELD ON 12-1-95

William E. Soderberg  
WILLIAM E. SODERBERG, P.S., CHAIRMAN

A	B	C	D	E	F	G	H	I	J	K	L	M
2	6	5	4	3	2							
3												
4	7	8	9	10	11	12						
5												
6	18	17	16	15	14	13						
7												
8	19	20	21	22	23	24						
9												
10	30	29	28	27	26	25						
11												
12	31	32	33	34	35	36						

**B. Description of corner evidence found and/or method applied in restoring or reestablishing corner:**

1995 Kennedy Surveying, Inc. - Kennedy, PS #17623 - Fnd 1/2" Iron in a Monument Box 3 feet East of the centerline of McKay Road extending to the North, which has a bituminous surface, and 1 foot South of the centerline of 33 Mile Road extending to the West, which has a bituminous surface, and a gravel surface extending to the East with a tree-fence row extending to the South.

Witnesses from LCRC #1 & 2 were used to recover and verify the location of the found 1/2" Iron in a Monument Box.


**FIELD MEASUREMENTS BETWEEN**

- K-11 to K-10 2428.22 Ft., GLO = 40 chains or 2640.00 Ft.
- K-11 to J-11 2629.83 Ft., GLO = 40.35 chains or 2663.10 Ft.

**C. Description of monument for corner and accessories established to perpetuate locating the position of the corner:**

- K-11 I replaced the found 1/2" Iron with a 3/4" x 24" Iron Rod w/2" diameter aluminum cap stamped "Macomb County Monument MI Act 345 #17623" in a existing Monument Box.
- S81°W 248.59' Set PK & Remon. Washer North face Power Pole
- S08°W 31.61' Set PK & Remon. Washer NW face Power Pole
- N63°E 95.07' Set PK & Remon. Washer West face Power Pole
- N06°E 203.03' Set PK & Remon. Washer SE face 21" Maple

The selected location is accepted by me and is generally accepted by Professional Surveyors as the best available evidence of the position of the original corner.

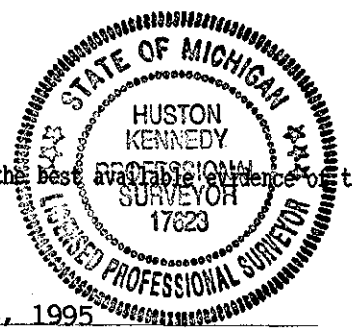

Signed by Huston K. Kennedy

Date December 4, 1995

Surveyor's Michigan License No. 17623