

LAND CORNER RECORDATION CERTIFICATE
 Filing Requirement of Act 74, Mich. P.A. 1970

For corners in

<u>Macomb</u> (County)	Located in: Bruce Township	Corner Code #
1. Public Land Survey	T <u>5N</u> R <u>12E</u>	<u>M-4</u>
	T _____ R _____	_____
	T _____ R _____	_____
2. Property Controlling in Section	S _____ T _____ R _____	_____
	S _____ T _____ R _____	_____
3. Miscellaneous Property in Sec.	S _____ T _____ R _____	_____
	S _____ T _____ R _____	_____

SURVEY & REMONUMENTATION

MAR 17 2000

SECTION

ACCEPTED BY THE MACOMB COUNTY SURVEY PEER GROUP AS THE OFFICIAL CORNER UNDER MICHIGAN PUBLIC ACT 345 OF 1990 AT A MEETING HELD ON 5-29-99

William E. Soderberg
 WILLIAM E. SODERBERG, P.S., CHAIRMAN

Register of Deeds Stamp & File Number

4. Lot No. _____ Recorded Plat _____
 5. Private Claims _____

	A	B	C	D	E	F	G	H	I	J	K	L	M
1													
2	6		5		4		3		2		1		
3													
4	7		8		9		10		11		12		
5													
6	18		17		16		15		14		13		
7													
8	19		20		21		22		23		24		
9													
10	30		29		28		27		26		25		
11													
12	31		32		33		34		35		36		
13													

I, Huston K. Kennedy, in a field survey on March 1, 1999 do hereby state that under requirements of P.A. 74, Michigan P.A. of 1970, the corner points mentioned in lines 1 and 2 above were in conformance with regulations and rules therefore as required in the current manual of survey instructions of the United States Department of the Interior, Bureau of Land Management or by a decree of a Court of Law and/or that the corner points mentioned in lines 3, 4 and 5 above were in conformance with the rules of the Michigan Board of Land Surveyors or by a Decree of a Court of Law, established, re-established, monumented, recovered, found as expressed below:


NOTE: Not more than 2 corners, all in the same town and range, may be recorded on this certificate.

- A. Description of original monument and accessories and/or subsequent restoration:
 1817-GLO Wampler, D.S.; Set Post 8" Elm N19°E 142 Links; 8" Elm N36°E 108 Links
 1.) 1972-Kobs, PS #14097; LCRC 2268, Pg.693 - Fnd 1/2" Pipe
 2.) 1972-Kobs, PS #14097; Survey L.2268, Pg.674 - Fnd 1/2" Pipe, used same wit as 1972 LCRC
 3.) 1972-Kobs, PS #14097; Survey L.2319, Pg.556 - Fnd 1/2" Pipe, used same wit as 1972 LCRC
 4.) 1976-Elnich, PS #18986; Survey L.2653, Pg.381 - Fnd 1/2" Iron
 5.) 1976-Elnich, PS #18986; Survey L.2653, Pg.382 - Fnd 1/2" Iron, used same wit as 1976 Survey
 6.) 1986-King, PS #30085; Unrecorded Survey - Fnd a 1/2" Pipe
 7.) 1988-King, PS #30085; Unrecorded Survey - Fnd a 7/8" Iron Bar
- B. Description of corner evidence found and/or method applied in restoring or reestablishing corner:
 1998-Kennedy Surveying, Inc. - Kennedy, PS #17623 - Fnd a 1/2" Iron Pipe in the existing centerline of Reid Road extending to the West. Reid Road has a gravel surface extending to the East & West. A tree-fence row extends to the North & South. The West 1/4 corner of Section 7, T5N, R13E, Amada Township (A-4) is located 137.04 feet to the South.

I accepted the found 1/2" Iron Pipe as the best evidence of the original corner position.

FIELD MEASUREMENTS BETWEEN

M-4 to A-4 No GLO 136.68 Ft. (MCPC Map) 137.04 Ft. (MEA 1999)	M-4 to M-5 GLO = 40 chains or 2640.00 Ft. No recorded distances 2661.63 Ft. (MEA 1999)
---	--

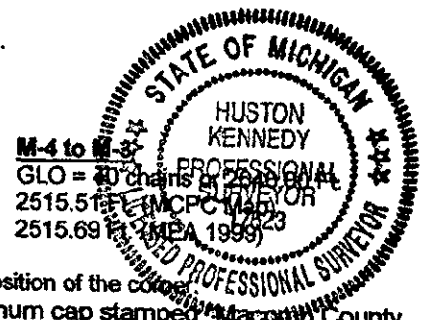

- C. Description of monument for corner and accessories established to perpetuate locating the position of the corner:
 M-4 I replaced the found 1/2" Iron Pipe with a 3/4" x 24" Iron Rod w/2" diameter aluminum cap stamped Macomb County Monument MI Act #345 #17623
 N03°E 54.62' Set Mag Nail & Remon Washer West face Power Pole
 N70°W 74.65' Set Mag Nail & Remon Washer SW face 29" Oak
 S40°W 45.25' Set Mag Nail & Remon Washer SW face 13" Cherry
 S03°E 37.75' Set Mag Nail & Remon Washer East face 13" Cherry
 South 137.04' West 1/4 corner of Section 7, T5N, R13E, Amada Township (A-4)

The selected location is accepted by me and is generally accepted by Professional Surveyors as the best available evidence the position of the original corner.

Signed by: *Huston Kennedy* Date 7-29-99
 Surveyor's Michigan License No. 17623

892