

APR 07 1998

LAND CORNER RECORDATION CERTIFICATE
Filing Requirement of Act 74, Mich. P.A. 1970

SECTION

For corners in

<u>Macomb</u> (County)	Located In: Bruce Township	Corner Code #
1. Public Land Survey	T <u>5N</u> R <u>12E</u>	<u>M-12</u>
	T <u> </u> R <u> </u>	<u> </u>
	T <u> </u> R <u> </u>	<u> </u>
	T <u> </u> R <u> </u>	<u> </u>
2. Property Controlling in Section	S <u> </u> T <u> </u> R <u> </u>	<u> </u>
	S <u> </u> T <u> </u> R <u> </u>	<u> </u>
3. Miscellaneous Property in Sec.	S <u> </u> T <u> </u> R <u> </u>	<u> </u>
	S <u> </u> T <u> </u> R <u> </u>	<u> </u>

Register of Deeds Stamp & File Number

4 Lot No. _____, Recorded Plat _____
 5 Private Claims _____

I, Huston K. Kennedy, in a field survey on 6/17, 19 97 do hereby state that under requirements of P.A. 74, Michigan P.A. of 1970, the corner points mentioned in lines 1 and 2 above were in conformance with regulations and rules therefore as required in the current manual of survey instructions of the United States Department of the Interior, Bureau of Land Management or by a decree of a Court of Law and /or that the corner points mentioned in lines 3, 4 and 5 above were in conformance with the rules of the Michigan Board of Land Surveyors or by a Decree of a Court of Law; established, re-established, monumented, recovered, found as expressed below:

NOTE: Not more than 2 corners, all in the same town and range, may be recorded on this certificate.

A	B	C	D	E	F	G	H	I	J	K	L	M
1												
2	6		5		4		3		2		1	
3												
4	7		8		9		10		11		12	
5												
6	16		17		16		15		14		13	
7												
8	19		20		21		22		23		24	
9												
10	30		29		28		27		26		25	
11												
12	31		32		33		34		35		36	
13												

A. Description of original monument and accessories and/or subsequent restoration:
 1817-GLO Wampler, D.S.; Set Post 17" Sugar Tree S30° E 8 Links; 5" Elm S59° W 16 Links
 1.) "ROMEO INDUSTRIAL PARK NO. 2", Liber 82, page 48-50

C0585104 LIBER:07660 PAGE:978 09:11A 10/01/1997
 CARMELLA SABAUGH-MACOMB COUNTY, MI REG/DEEDS

B. Description of corner evidence found and/or method applied in restoring or reestablishing corner:
 1997 Kennedy Surveying, Inc. - Kennedy, PS #17623 - Fnd 1/2" Iron Pipe in a Monument Box in the existing centerline of Powell Road extending to the North & South, which has a concrete surface. There is a power pole line extending to the East, no line of occupation to the West. This corner is being used and accepted as common corners with the West 1/4 corner of Section 31, T5N, R13E, Armada Township (A-12).

See back side of LCRC for Field Measurements


ACCEPTED BY THE MACOMB COUNTY SURVEY PEER GROUP AS THE OFFICIAL CORNER UNDER MICHIGAN PUBLIC ACT 345 OF 1990 AT A MEETING HELD ON 8/5/97
William E. Soderberg
 WILLIAM E. SODERBERG, P.S., CHAIRMAN

C. Description of monument for corner and accessories established to perpetuate locating the position of the corner:
 M-12 I replaced the found 1/2" Iron Pipe with a 3/4" x 24" Iron Rod w/2" diameter aluminum cap stamped "Macomb County Monument MI Act 345 #17623 in a existing Monument Box
 N23°W 107.67' Set PK & Remon Washer NE face Power Pole
 N36°E 95.40' Set PK & Remon Wahser NW face 10" Hickory
 S54°W 68.50' Set PK & Remon Washer SE face 12" Poplar
 S88°E 57.61' Set PK & Remon Washer South face Power Pole

The selected location is accepted by me and is generally accepted by Professional Surveyors as the best available evidence of the position of the original corner.

Signed by Huston K. Kennedy
 Surveyor's Michigan License No. 17623

Date 8-8-97

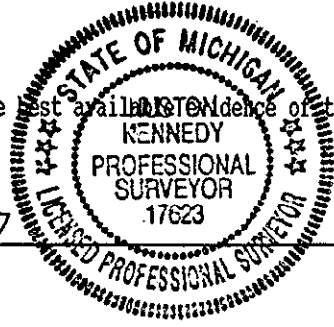

gx ✓

767

C0585104 LIBER:07660 PAGE:979 09:11A 10/01/1997
CARMELLA SABAUGH-MACOMB COUNTY, MI REG/DEEDS

FIELD MEASUREMENTS BETWEEN

M-12 to M-11

GLO = 40 chains or 2640.00 Ft.
GROUND-MEA = 2743.70 Ft.
GRID-MEA = 2743.43 Ft. or GROUND CAL. = 2743.68 Ft.

M-12 to M-13

GLO = 40 chains or 2640.00 Ft.
M.C.P.C. Map (1-36H) = 2629.94 Ft. (Cal.) & 2660.30 Ft.
GROUND-MEA = 2659.50 Ft.
GRID-MEA = 2659.12 Ft. or GROUND CAL. = 2659.36 Ft.