

LAND CORNER RECORDATION CERTIFICATE  
 Filing Requirement of Act 74, Mich. P.A. 1970

For corners in

Macomb (County)	Located In: Armada Township	Corner Code #
1. Public Land Survey	T <u>5N</u> R <u>13E</u>	<u>A-11</u>
	T <u>    </u> R <u>    </u>	<u>    </u>
	T <u>    </u> R <u>    </u>	<u>    </u>
	T <u>    </u> R <u>    </u>	<u>    </u>
2. Property Controlling in Section	S <u>    </u> T <u>    </u> R <u>    </u>	<u>    </u>
	S <u>    </u> T <u>    </u> R <u>    </u>	<u>    </u>
3. Miscellaneous Property in Sec.	S <u>    </u> T <u>    </u> R <u>    </u>	<u>    </u>
	S <u>    </u> T <u>    </u> R <u>    </u>	<u>    </u>

SURVEY &  
 REMONUMENTATION

APR 07 1998

SECTION

Register of Deeds Stamp & File Number

4. Lot No. \_\_\_\_\_, Recorded Plat \_\_\_\_\_  
 5. Private Claims \_\_\_\_\_

I, Huston K. Kennedy, in a field survey on 6/18, 1997 do hereby state that under requirements of P.A. 74, Michigan P.A. of 1970, the corner points mentioned in lines 1 and 2 above were in conformance with regulations and rules therefore as required in the current manual of survey instructions of the United States Department of the Interior, Bureau of Land Management or by a decree of a Court of Law and /or that the corner points mentioned in lines 3, 4 and 5 above were in conformance with the rules of the Michigan Board of Land Surveyors or by a Decree of a Court of Law; established, re-established, monumented, recovered, found as expressed below:

NOTE: Not more than 2 corners, all in the same town and range, may be recorded on this certificate.

	A	B	C	D	E	F	G	H	I	J	K	L	M
1													
2	6		5		4		3		2		1		
3													
4	7		8		9		10		11		12		
5													
6	18		17		16		15		14		13		
7													
8	19		20		21		22		23		24		
9													
10	30		29		28		27		26		25		
11													
12	31		32		33		34		35		36		
13													

A. Description of original monument and accessories and/or subsequent restoration:

- 1817-GLO Wampler, D.S.; Set Post
- 1.) 1995-King, PS #30085; LCRC L.6586, Pg.180 - Fnd 1/2" Iron
- 2.) 1992-King, PS #30085; Survey L5969, Pg.128 - Fnd 1/2" Iron, used same wit as 1995 LCRC
- 3.) 1977-Dely, PS #5234; Unrecorded Survey - Fnd Iron Pipe
- 4.) 1989-Dunn, PS #28408; Unrecorded Survey - Set a 1/2" Iron Rod with cap #28408
- 5.) 1989-Dunn, PS #28408; Unrecorded Survey - Set a 1/2" Iron Rod with cap #28408, used same wit as Survey #4

B. Description of corner evidence found and/or method applied in restoring or reestablishing corner:

1997 Kennedy Surveying, Inc. - Kennedy, PS #17623 - Fnd 1/2" Iron Rod 5" below the gravel surface and in the existing centerline of Powell Road extending to the South, which has a concrete surface and in the existing centerline of 33 Mile Road extending to the East, which has a gravel surface. A tree-fence row extending to the North. This corner position was not accepted. The corner was recovered on a straight line between M-11 and M-12 at a distance of 66.01 feet South of M-11 based upon a unrecorded survey by G. Dely, PS #5234 in 1977 and is 44.9 feet North of the end of the concrete pavement for Powell Road. Corner common to Sections 35 & 36, T5N, R12E, Bruce Township (M-11) is located 66.01 feet to the North.

The unrecorded Survey #3 was used to recover this corner.

See back side of LCRC for Field Measurements

ACCEPTED BY THE MACOMB COUNTY SURVEY PEER GROUP AS THE OFFICIAL CORNER UNDER MICHIGAN PUBLIC ACT 345 OF 1990 AT A MEETING HELD ON 9-23-97

William E. Soderberg  
 WILLIAM E. SODERBERG, P.S., CHAIRMAN


C. Description of monument for corner and accessories established to perpetuate locating the position of the corner:

- A-11 I set a 3/4" x 24" Iron Rod w/2" diameter aluminum cap stamped "Macomb County Monument MI Act 345" #17623 on the range line in a New Monument Box
- S59°E 59.25' Set PK & Remon Washer SW face Power Pole
- S75°W 57.81' Set PK & Remon Washer NW face Power Pole
- N52°W 115.89' Set PK & Remon Washer SW face 16" Elm
- Due North 93.51' Set PK & Remon Washer East face 19" Elm
- North 66.01 feet, corner common to Sections 35 & 36, T5N, R12E, Bruce Township, (M-11)
- North 4.27 feet found 1/2" Iron Rod is being used as a property controlling corner

The selected location is accepted by me and is generally accepted by Professional Surveyors as the best available evidence of the position of the original corner.

Signed by [Signature]  
 Surveyor's Michigan License No. 17623

Date 10-21-97

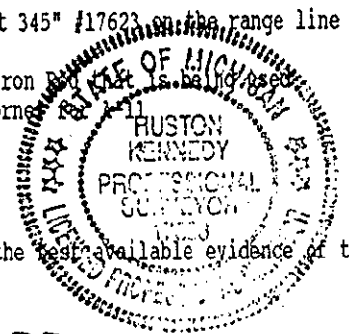

739

FIELD MEASUREMENTS BETWEEN

A-11 to A-12

No GLO

H.C.P.C. Map (2-31A) = 2741 Ft.  $\pm$

GROUND-MEA = 2677.62 Ft.

GRID-MEA = 2677.38 Ft. or GROUND CAL. = 2667.62 Ft.

A-11 to H-11

GLO = 1.00 chains or 66.00 Ft.

GROUND-MEA = 66.01 Ft.

C0619499 LIBER:07769 PAGE:482 08:30A 12/12/1997  
CARMELLA SABAUGH-MACOMB COUNTY, MI REG/DEEDS