

**SURVEY &
REMONUMENTATION**

C0623388 LIBER:07783 PAGE:240 09:55A 12/ APR 1997 1998
CARMELLA SABAUGH-MACOMB COUNTY, MI REG/DEEDS

LAND CORNER RECORDATION CERTIFICATE
Filing Requirement of Act 74, Mich. P.A. 1970

SECTION

For corners in

<u>MACOMB</u> (County)	Located In:	Corner Code #
	<u>ARMADA TOWNSHIP</u>	
1. Public Land Survey	<u>T 5N R 13E</u>	<u>M-1</u>
	T _____ R _____	_____
	T _____ R _____	_____
	T _____ R _____	_____
2. Property Controlling in Section	S _____ T _____ R _____	_____
	S _____ T _____ R _____	_____
3. Miscellaneous Property in Sec.	S _____ T _____ R _____	_____
	S _____ T _____ R _____	_____

Register of Deeds Stamp & File Number

4. Lot No. _____, Recorded Plat _____
5. Private Claims _____

I, ROBERT H. BIRKETT, in a field survey on JULY 22, 1997 do hereby certify that under requirements of P.A. 74, Michigan P.A. of 1970, the corner points mentioned in lines 1 and 2 above were in conformance with regulations and rules therefore as required in the current manual of survey instructions of the United States Department of the Interior, Bureau of Land Management or by a decree of a Court of Law and for that the corner points mentioned in lines 3, 4 and 5 above were in conformance with the rules of the Michigan Board of Land Surveyors or by a Decree of a Court of Law; established, re-established, monumented, re-monumented, recovered, found as expressed below:

NOTE: Not more than 2 corners, all in the same town and range, may be recorded on this certificate.

A	B	C	D	E	F	G	H	I	J	K	L	M
1												
2	6		5		4		3		2		1	
3												
4	7		8		9		10		11		12	
5												
6	18		17		16		15		14		13	
7												
8	19		20		21		22		23		24	
9												
10	30		29		28		27		26		25	
11												
12	31		32		33		34		35		36	
13												

A. Description of original monument and accessories and/or subsequent restoration:
1817, W. PRESTON, SET CEDAR POST, GLO
1936, M.O. PECK, REPLACED CEDAR POST UNDER LARGE STONE W/STANDARD CONC. MONUMENT, S.C.C. NOTES.
1987, D. KING #30085, FOUND 3/4" IRON, SURVEY, L. 9, P. 492 S.C.C.R.
1990, H. KOBS #14097, FOUND BOAT SPIKE, SURVEY, L. 5082, P. 40, M.C.R.
1992, D. KING #30085, FOUND BOAT SPIKE, SURVEY LIBER UNKNOWN.

B. Description of corner evidence found and/or method applied in restoring or reestablishing corner:
FOUND SQUARE BOAT SPIKE IN MONUMENT BOX IN CENTER ASPHALT ROAD WITCH MATCHES THE WITNESSES (LISTED IN SECTION "C") OF THE ABOVE DESCRIBED DOCUMENTS (LISTED IN SECTION "A")


CORNER COMMON TO: A-1, RICHMOND TOWNSHIP, T. 5 N., R. 14 E., MACOMB COUNTY.
M-13, BERLIN TOWNSHIP, T. 6 N., R. 13 E., ST. CLAIR COUNTY.
A-13, RILEY TOWNSHIP, T. 6 N., R. 14 E., ST. CLAIR COUNTY.

DISTANCE M-1 TO M-2
GLO 40 CHAINS (2640')
SURVEY L. 5082 P. 40 M.C.R. 2739.87'
SURVEY LIBER UNKNOWN 2739.90'
FIELD (GROUND) 2739.94'

ACCEPTED BY THE MACOMB COUNTY SURVEY PEER GROUP AS THE OFFICIAL CORNER UNDER MICHIGAN PUBLIC ACT 345 OF 1990 AT A MEETING HELD ON 8-5-97
William E. Soderberg
WILLIAM E. SODERBERG, P.S., CHAIRMAN

C. Description of monument for corner and accessories established to perpetuate locating the position of the corner:
REMOVED EXISTING SQUARE BOAT SPIKE AND REPLACED WITH A 3/4" X 24" IRON WITH 2" DIAMETER ALUMINUM CAP STAMPED "MACOMB COUNTY MONUMENT MI ACT 345 M-1, A-1, 41094", IN AN EXISTING MONUMENT BOX.

- AZ. 30° - 26.40' - FOUND N.E. CORNER CURVED CONC. HEADWALL.
- AZ. 50° - 36.70' - FOUND 60p NAIL IN S.E. FACE UTILITY POLE.
- AZ. 50° - 41.90' - FOUND BUSTED 4" ROUND CONC. PILLAR
- AZ. 150° - 35.18' - FOUND CUT "+" AT SOUTH END ROCK HEADWALL.
- AZ. 155° - 42.98' - FOUND 60p NAIL IN N.E. FACE UTILITY POLE W/LIGHT.
- AZ. 230° - 46.60' - FOUND 1/2" RE-ROD #19835.
- AZ. 300° - 28.00' - FOUND S.W. CORNER CURVED CONC. HEADWALL.
- AZ. 340° - 27.10' - FOUND N.W. CORNER CURVED CONC. HEADWALL.

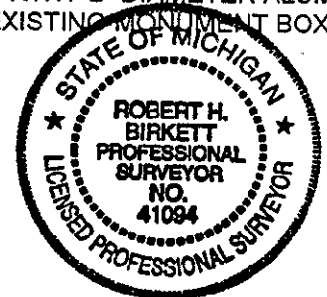

THE SELECTED LOCATION IS ACCEPTED BY ME AND IS GENERALLY ACCEPTED BY PROFESSIONAL SURVEYORS AS THE BEST AVAILABLE EVIDENCE OF THE POSITION OF THE ORIGINAL CORNER.

Signed by Robert H. Birkett Date 12-14-97
Surveyor's Michigan License No. 41094

708