

**SURVEY &
REMONUMENTATION**

0019831 LIBER:06543 PAGE:353 08:35A 01/05/1995
CARMELLA SABAUGH-MACOMB COUNTY, MI REG/DEEDS

APR 28 1995

**LAND CORNER RECORDATION CERTIFICATE
Filing Requirement of Act 74, Mich. P.A. 1970**

For corners in **COMMISSION**

<u>MACOMB</u> (County)	Located In:	Corner Code #
	<u>ARMADA TOWNSHIP</u>	
1. Public Land Survey	<u>T 5N R 13E</u>	<u>M-13</u>
	T _____ R _____	_____
	T _____ R _____	_____
	T _____ R _____	_____
2. Property Controlling in Section	S _____ T _____ R _____	_____
	S _____ T _____ R _____	_____
3. Miscellaneous Property in Sec.	S _____ T _____ R _____	_____
	S _____ T _____ R _____	_____

Register of Deeds Stamp & File Number

4. Lot No. _____, Recorded Plat _____
5. Private Claims _____

I, CRAIG P. AMEY, in a field survey on AUGUST 25, 1994 do hereby certify that under requirements of P.A. 74, Michigan P.A. of 1970, the corner points mentioned in lines 1 and 2 above were in conformance with regulations and rules therefore as required in the current manual of survey instructions of the United States Department of the Interior, Bureau of Land Management or by a decree of a Court of Law and /or that the corner points mentioned in lines 3, 4 and 5 above were in conformance with the rules of the Michigan Board of Land Surveyors or by a Decree of a Court of Law; established, re-established, monumented, re-monumented, recovered, found as expressed below:

NOTE: Not more that 4 corners, all in the same town and range, may be recorded on this certificate.

	A	B	C	D	E	F	G	H	I	J	K	L	M
1													
2	6		5		4		3		2		1		
3													
4	7		8		9		10		11		12		
5													
6	18		17		16		15		14		13		
7													
8	19		20		21		22		23		24		
9													
10	30		29		28		27		26		25		
11													
12	31		32		33		34		35		36		
13													

A. Description of original monument and accessories and/or subsequent restoration:

1817	G.L.O. PAGE 361-364	WILLIAM PRESTON	NO ORIGINAL WITNESSES REMAIN
1972	LCRC LIBER 2319 PAGE 549	HERBERT J. KOBBS, #14097	FOUND 1/2' PIPE IN MONUMENT BOX.
1978	LCRC LIBER 2923 PAGE 874	HERBERT J. KOBBS, #14097	FOUND 1/2" PIPE IN MONUMENT BOX.


ACCEPTED BY THE MACOMB COUNTY SURVEY PEER GROUP AS THE OFFICIAL CORNER UNDER MICHIGAN PUBLIC ACT 345 OF 1990 AT A MEETING HELD ON 10-19-94

William E. Soderberg
WILLIAM E. SODERBERG, P.S., CHAIRMAN

B. Description of corner evidence found and/or method applied in restoring or reestablishing corner:

FOUND 1/2" PIPE IN A MONUMENT BOX AT THE INTERSECTION OF OMO ROAD AND 32 MILE ROAD

1972	LCRC LIBER 2319 PAGE 549	FOUND NORTHEAST 71.78'	PK NAIL AND MCRC CAP IN BELL TELEPHONE POLE
1978	LCRC LIBER 2923 PAGE 874	FOUND NORTHWEST 54.05'	PK NAIL AND MCRC CAP IN POWER POLE
		FOUND SOUTHWEST 65.97'	PK NAIL AND MCRC CAP IN POWER POLE

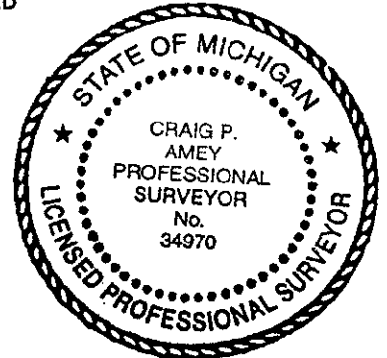

C. Description of monument for corner and accessories established to perpetuate locating the position of the corner:

REPLACED PIPE WITH 3/4" X 24" REBAR WITH ALUMINUM MACOMB COUNTY REMONUMENTATION CAP #34970 IN EXISTING MONUMENT BOX

AZIMUTH 245°	66.56'	FOUND,	PK NAIL IN THE SOUTH FACE OF A UTILITY POLE
AZIMUTH 320°	54.02'	FOUND,	PK NAIL IN THE WEST FACE OF A UTILITY POLE
AZIMUTH 60°	71.79'	FOUND,	PK NAIL IN THE NORTH FACE OF A UTILITY POLE
AZIMUTH 170°	128.74'	FOUND,	SET PK NAIL AND MCR TAG IN THE WEST FACE OF A 36" MAPLE

THE SELECTED LOCATION IS ACCEPTED BY ME AND IS GENERALLY ACCEPTED BY PROFESSIONAL SURVEYORS AS THE BEST AVAILABLE EVIDENCE OF THE POSITION OF THE ORIGINAL CORNER.

Signed by Craig P. Amey Date 12-15-94
Surveyor's Michigan License No. 34970