


**LAND CORNER RECORDATION CERTIFICATE**  
 Filing Requirement of Act 74, Mich. P.A. 1970

For corners in

<u>MACOMB</u> (County)	Located In:	Corner Code #
	RICHMOND TOWNSHIP	
1. Public Land Survey	T <u>5N</u> R <u>14E</u>	<u>M-1</u>
	T ___ R ___	___
	T ___ R ___	___
	T ___ R ___	___
2. Property Controlling in Section	S ___ T ___ R ___	___
	S ___ T ___ R ___	___
3. Miscellaneous Property in Sec.	S ___ T ___ R ___	___
	S ___ T ___ R ___	___

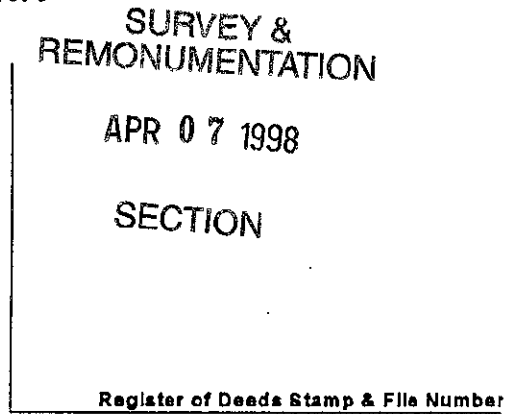

4. Lot No. \_\_\_\_\_, Recorded Plat \_\_\_\_\_  
 5. Private Claims \_\_\_\_\_

I, ROBERT H. BIRKETT, in a field survey on JULY 22, 1997 do hereby certify that under requirements of P.A. 74, Michigan P.A. of 1970, the corner points mentioned in lines 1 and 2 above were in conformance with regulations and rules therefore as required in the current manual of survey instructions of the United States Department of the Interior, Bureau of Land Management or by a decree of a Court of Law and /or that the corner points mentioned in lines 3, 4 and 5 above were in conformance with the rules of the Michigan Board of Land Surveyors or by a Decree of a Court of Law; established, re-established, monumented, re-monumented, recovered, found as expressed below:

A	B	C	D	E	F	G	H	I	J	K	L	M
1												
2	6	5	4	3	2	1						
3												
4	7	8	9	10	11	12						
5												
6	18	17	16	15	14	13						
7												
8	19	20	21	22	23	24						
9												
10	30	29	28	27	26	25						
11												
12	31	32	33	34	35	36						
13												

NOTE: Not more than 2 corners, all in the same town and range, may be recorded on this certificate.

A. Description of original monument and accessories and/or subsequent restoration:  
 1817, W. PRESTON, SET CEDAR POST, GLO  
 1936, M.O. PECK, REPLACED LG. STONE & CROCKERY W/STANDARD CONC. MONUMENT, S.C.C. NOTES.  
 1974, H. KOBBS #14097, FOUND CONCRETE MONUMENT, L.C.R.C. L. 2, P. 131 M.C.R.  
 1988, S.C.C.R.C., FOUND CONCRETE MONUMENT, S.C.C.R.C. FIELD NOTES.  
 1993, G.G. JAMES #19835, FOUND CONCRETE MONUMENT IN MONUMENT BOX, SURVEY L.14, P.284 S.C.C.R.

B. Description of corner evidence found and/or method applied in restoring or reestablishing corner:  
 FOUND 1" PIPE ENCASED IN CONCRETE IN MONUMENT BOX AT CENTERLINE OF ASPHALT ROAD.  
 CORNER COMMON TO : A-1, COLUMBUS TOWNSHIP, T. 5 N., R. 15 E., ST. CLAIR COUNTY.  
 A-13, WALES TOWNSHIP, T. 6 N., R. 15 E., ST. CLAIR COUNTY.  
 M-13, RILEY TOWNSHIP, T. 6 N., R. 14 E., ST. CLAIR COUNTY.

MONUMENT MATCHES THE WITNESSES (LISTED IN SECTION "C") OF THE ABOVE DESCRIBED DOCUMENTS (LISTED IN SECTION "A")

DISTANCE M-01 TO M-02  
 GLO 40 CHAINS (2640')  
 L. 14, P. 284 S.C.C.R. 2672.30'  
 FIELD 2672.02'

ACCEPTED BY THE MACOMB COUNTY SURVEY PEER GROUP AS THE OFFICIAL CORNER UNDER MICHIGAN PUBLIC ACT 345 OF 1990 AT A MEETING HELD ON 5-5-97  
  
 WILLIAM E. SODERBERG, P.S., CHAIRMAN

C. Description of monument for corner and accessories established to perpetuate locating the position of the corner:  
 CAPPED EXISTING 1" PIPE ENCASED IN CONCRETE WITH A 1-1/2" DIAMETER CAP STAMPED WITH ACT 345  
 EXISTING MONUMENT BOX.

AZ. 30° - 52.17' - FOUND NOTCH IN NORTH FLANGE 24" CMP.  
 AZ. 50° - 26.60' - FOUND NOTCH IN SOUTH FLANGE 24" CMP.  
 AZ. 150° - 35.15' - FOUND DOUBLE P.K. NAILS IN S.W. FACE TELEPHONE POLE.  
 AZ. 230° - 35.91' - FOUND P.K. NAIL W/S.C.C.R.C. TAG IN S.E. FACE UTILITY POLE.  
 AZ. 260° - 65.60' - FOUND CUT SQUARE IN 1' SQUARE PILLAR (BROKEN).



THE SELECTED LOCATION IS ACCEPTED BY ME AND IS GENERALLY ACCEPTED BY PROFESSIONAL SURVEYORS AS THE BEST AVAILABLE EVIDENCE OF THE POSITION OF THE ORIGINAL CORNER.

Signed by Robert H. Birkett Date 12/10/97  
 Surveyor's Michigan License No. 41094

723