

LAND CORNER RECORDATION CERTIFICATE
 Filing Requirement of Act 74, Mich. P.A. 1970

For corners in

RICHMOND TOWNSHIP
 Located in: Corner Code #

MACOMB
 (County)

- | | | | |
|------------------------------------|-------|---------------------|------------|
| 1. Public Land Survey | | <u>T 5 N R 14 E</u> | <u>M-2</u> |
| | | T ___ R ___ | _____ |
| | | T ___ R ___ | _____ |
| | | T ___ R ___ | _____ |
| 2. Property Controlling in Section | S ___ | T ___ R ___ | _____ |
| | S ___ | T ___ R ___ | _____ |
| 3. Miscellaneous Property in Sec. | S ___ | T ___ R ___ | _____ |
| | S ___ | T ___ R ___ | _____ |
4. Lot No. _____, Recorded Plat _____
 5. Private Claims _____

SURVEY &
 REMONUMENTATION

MAR 15 1999

SECTION

Register of Deeds Stamp & File Number

I, ROBERT H. BIRKETT, in a field survey on MARCH 25, 1998 do hereby certify that under requirements of P.A. 74, Michigan P.A. of 1970, the corner points mentioned in lines 1 and 2 above were in conformance with regulations and rules therefore as required in the current manual of survey instructions of the United States Department of the Interior, Bureau of Land Management or by a decree of a Court of Law and /or that the corner points mentioned in lines 3, 4 and 5 above were in conformance with the rules of the Michigan Board of Land Surveyors or by a Decree of a Court of Law, established, re-established, monumented, re-monumented, recovered, found as expressed below:

NOTE: Not more than 2 corners, all in the same town and range, may be recorded on this certificate.

	A	B	C	D	E	F	G	H	I	J	K	L	M
1													
2		6		5		4		3		2		1	
3													
4		7		8		9		10		11		12	
5													
6		16		17		16		15		14		13	
7													
8		19		20		21		22		23		24	
9													
10		30		29		28		27		26		25	
11													
12		31		32		33		34		35		36	
13													

A. Description of original monument and accessories and/or subsequent restoration:

- M-2, 1817, W. PRESTON, GLO, SET POST.
 1.) 1970, W. SODDERBERG, 17635, SET 3/4" PIPE, AEW RECORDS.
 2.) 1977, H. KOBS, 14097, FND. 1/2" PIPE, L. 2923, P. 879 M.C.R.
 3.) 1993, G. JAMES, 19835, FND. BENT LEAD PIPE, SET 1/2" BAR, L.14 (SUR.), P.254 S.C.C.R.
 4.) 1989, C. McDANIEL, 15405, FND 1/2" IRON PIPE, UNRECORDED SURVEY.

ACCEPTED BY THE MACOMB COUNTY SURVEY PEER GROUP AS THE OFFICIAL CORNER UNDER MICHIGAN PUBLIC ACT 345 OF 1990 AT A MEETING HELD ON 9/7/98

William E. Soderberg
 WILLIAM E. SODERBERG, P.S., CHAIRMAN


B. Description of corner evidence found and/or method applied in restoring or reestablishing corner:
 M-2 FOUND 1/2" IRON AT THE CENTER OF THE GRAVEL STODDARD ROAD 0.3' DEEP.

DISTANCE BETWEEN M-2 RICHMOND TWP., MACOMB CNTY. & A-2 COLUMBUS TWP., ST. CLAIR CNTY. - (FND. 165.55)
 146.05' (1) 145.7' (3) 145.7' (4)
 93.73' (1), 91.70' (2), 91.70' (4) - SSW - P.K. IN D.E. POLE - (FD. 91.92')
 27.52' (1), 27.52' (4) - WEST - P.K. IN POWER POLE - (FD. 26.95')

FIELD MEASUREMENTS

M-2 TO M-1, GLO (1817) - 40 CHAINS (2640')
 JAMES (1983) - 2672.30'
 REMONUMENTATION - 2672.03'

M-2 TO M-3, GLO (1817) - 40 CHAINS (2640')
 McDANIEL (1989) - 2669.71
 REMONUMENTATION 2670.22'

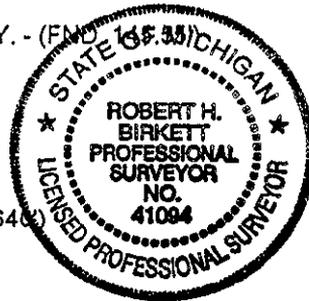

C. Description of monument for corner and accessories established to perpetuate locating the position of the corner:
 M-2 REPLACED 1/2" IRON WITH A 3/4" X 24" RE-BAR WITH A 2" DIAMETER ALUMINUM CAP STAMPED "MACOMB COUNTY MONUMENT, MI ACT 345, #41094, M-2".

- AZ. 0° - 145.55' - FOUND 1" PIPE IN ASPHALT ROAD, A-2, COLUMBUS TOWNSHIP, ST. CLAIR COUNTY, T. 5 N., R 15 E.
 AZ. 25° - 130.55' - SET MACOMB COUNTY RE-MON TAG IN WEST FACE UTILITY POLE.
 AZ. 150° - 135.95' - NORTHWEST CORNER OF SMALL BLOCK BUILT BUILDING.
 AZ. 190° - 91.92' - FOUND P.K. NAIL IN EAST FACE UTILITY POLE, SET MACOMB COUNTY RE-MON TAG.
 AZ. 260° - 26.95' - FOUND NAIL IN SOUTH FACE UTILITY POLE, SET MACOMB COUNTY RE-MON TAG.

THE SELECTED LOCATION IS ACCEPTED BY ME AND IS GENERALLY ACCEPTED BY PROFESSIONAL SURVEYORS AS THE BEST AVAILABLE EVIDENCE OF THE POSITION OF THE ORIGINAL CORNER.

Signed by Robert H. Birkett Date 11-24-98
 Surveyor's Michigan License No. 41094

835