


LAND CORNER RECORDATION CERTIFICATE
 Filing Requirement of Act 74, Mich. P.A. 1970

For corners in

MACOMB
 (County)

RICHMOND TOWNSHIP
 Located In: Corner Code #

- | | | | |
|------------------------------------|-------|---------------------|------------|
| 1. Public Land Survey | | <u>T 5 N R 14 E</u> | <u>M-3</u> |
| | | T ___ R ___ | _____ |
| | | T ___ R ___ | _____ |
| | | T ___ R ___ | _____ |
| 2. Property Controlling in Section | S ___ | T ___ R ___ | _____ |
| | S ___ | T ___ R ___ | _____ |
| 3. Miscellaneous Property in Sec. | S ___ | T ___ R ___ | _____ |
| | S ___ | T ___ R ___ | _____ |

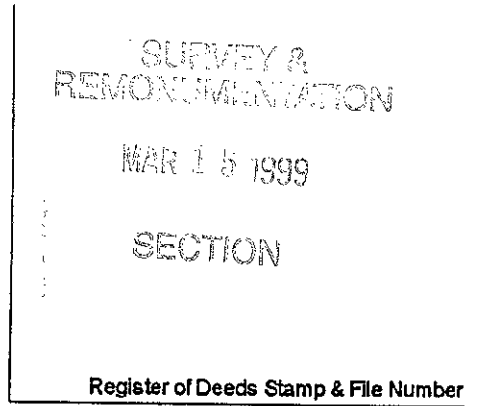

4. Lot No. _____, Recorded Plat _____
 5. Private Claims _____

I, ROBERT H. BIRKETT, in a field survey on APRIL 11, 1998 do hereby certify that under requirements of P.A. 74, Michigan P.A. of 1970, the corner points mentioned in lines 1 and 2 above were in conformance with regulations and rules therefore as required in the current manual of survey instructions of the United States Department of the Interior, Bureau of Land Management or by a decree of a Court of Law and /or that the corner points mentioned in lines 3, 4 and 5 above were in conformance with the rules of the Michigan Board of Land Surveyors or by a Decree of a Court of Law; established, re-established, monumented, re-monumented, recovered, found as expressed below:

	A	B	C	D	E	F	G	H	I	J	K	L	M
1													
2		6	5	4	3	2	1						
3													
4		7	8	9	10	11	12						
5													
6		16	17	16	15	14	13						
7													
8		19	20	21	22	23	24						
9													
10		30	29	28	27	26	25						
11													
12		31	32	33	34	35	36						
13													

NOTE: Not more than 2 corners, all in the same town and range, may be recorded on this certificate.

A. Description of original monument and accessories and/or subsequent restoration:

- M-3 1817, W. PRESTON, GLO, SET POST.
 1) 1970, W. SODERBERG, FND. RE-ROD, AEW RECORDS.
 2) 1978, H. KOBBS, FND. 1/2" IRON BAR, L. 2923, P. 879, M.C.R.
 3) 1989, C. McDANIEL, 1/2" IRON, UNRECORDED SURVEY

ACCEPTED BY THE MACOMB COUNTY SURVEY PEER GROUP AS THE OFFICIAL CORNER UNDER MICHIGAN PUBLIC ACT 345 OF 1990 AT A MEETING HELD ON 4/27/98

 WILLIAM E. SODERBERG, P.S., CHAIRMAN

B. Description of corner evidence found and/or method applied in restoring or reestablishing corner:


M-3 ON APRIL 11, 1998 FOUND 1" PIPE OVER 1/2" IRON AT CENTER OF GRAVEL STODDARD ROAD, 0.5' DEEP.

49.02' (1, 2), 49.1' (3) - NW - P.K. IN 24" CATALPA (FND. 49.20' CENTER OF STUMP)

FIELD MEASUREMENTS M-3 TO A-3 PRESTON (1817) 0.21 CHAINS - 182.23' MEASURED.
 M-3 TO M-2, GLO (1817) - 40 CHAINS (2640') M-3 TO M-4, GLO (1817) - 40 CHAINS (2640')
 McDANIEL (1989) - 2669.71' NO PREVIOUS RECORDED DISTANCE
 MACOMB COUNTY TAX RECORDS - 2669.62' RE-MONUMENTATION (1998) - 2667.86'.
 RE-MONUMENTATION (1998) - 2670.22'.
 M-3 TO A-3 GLO 46.86'

C. Description of monument for corner and accessories established to perpetuate locating the position of the corner:

M-3 REPLACED 1" PIPE OVER 1/2" IRON WITH A 3/4" X 24" RE-BAR WITH A 2" DIAMETER ALUMINUM CAP STAMPED "MACOMB COUNTY MONUMENT, MI ACT 345, #41094, M-3".

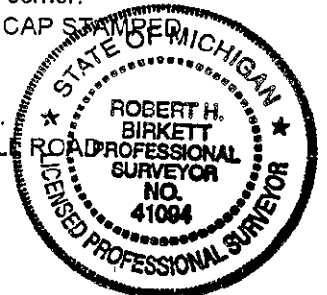

- AZ. 0° - 182.23' - FOUND 3/4" PIPE, A-3 COLUMBUS TOWNSHIP, ST. CLAIR COUNTY, T. 5 N., R. 15 E.
- AZ. 80° - 176.90' - NORTHWESTERLY CORNER OF BRICK AND VINYL SIDED HOUSE #10479 CARROLL ROAD
- AZ. 165° - 65.55' - FOUND NOTCH IN EAST END 15" CMP ROAD CULVERT.
- AZ. 190° - 183.94' - SET MACOMB COUNTY RE-MON TAG IN EAST FACE UTILITY POLE.
- AZ. 270° - 29.72' - SET MACOMB COUNTY RE-MON TAG IN N. FACE 4" SQUARE WOOD POST.
- AZ. 335° - 49.20' - FOUND 34" CATALPA STUMP AND SET RE-MON TAG @ CENTER.

THE SELECTED LOCATION IS ACCEPTED BY ME AND IS GENERALLY ACCEPTED BY PROFESSIONAL SURVEYORS AS THE BEST AVAILABLE EVIDENCE OF THE POSITION OF THE ORIGINAL CORNER.

Signed by Robert H. Birkett Date 11-24-98
 Surveyor's Michigan License No. 41094

836