


**LAND CORNER RECORDATION CERTIFICATE**  
 Filing Requirement of Act 74, Mich. P.A. 1970

For corners in

RICHMOND TOWNSHIP  
 Located In: Corner Code #

MACOMB  
 (County)

- |                                    |       |                     |            |
|------------------------------------|-------|---------------------|------------|
| 1. Public Land Survey              |       | <u>T 5 N R 14 E</u> | <u>M-4</u> |
|                                    |       | T ___ R ___         | _____      |
|                                    |       | T ___ R ___         | _____      |
|                                    |       | T ___ R ___         | _____      |
| 2. Property Controlling in Section | S ___ | T ___ R ___         | _____      |
|                                    | S ___ | T ___ R ___         | _____      |
| 3. Miscellaneous Property in Sec.  | S ___ | T ___ R ___         | _____      |
|                                    | S ___ | T ___ R ___         | _____      |

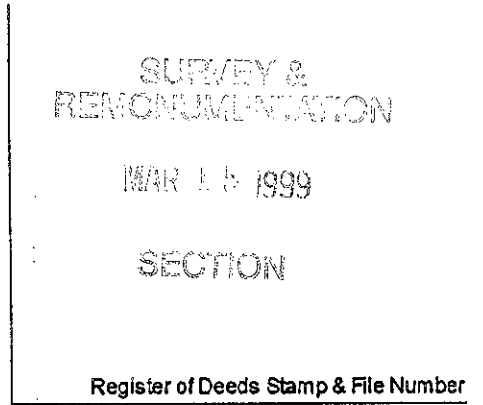

4. Lot No. \_\_\_\_\_, Recorded Plat \_\_\_\_\_  
 5. Private Claims \_\_\_\_\_

I, ROBERT H. BIRKETT, in a field survey on APRIL 11, 1998 do hereby certify that under requirements of P.A. 74, Michigan P.A. of 1970, the corner points mentioned in lines 1 and 2 above were in conformance with regulations and rules therefore as required in the current manual of survey instructions of the United States Department of the Interior, Bureau of Land Management or by a decree of a Court of Law and /or that the corner points mentioned in lines 3, 4 and 5 above were in conformance with the rules of the Michigan Board of Land Surveyors or by a Decree of a Court of Law, established, re-established, monumented, re-monumented, recovered, found as expressed below:

1	A	B	C	D	E	F	G	H	I	J	K	L	M
2		6		5		4		3		2		1	
3													
4		7		8		9		10		11		12	
5													
6		16		17		16		15		14		13	
7													
8		19		20		21		22		23		24	
9													
10		30		29		28		27		26		25	
11													
12		31		32		33		34		35		36	
13													

NOTE: Not more than 2 corners, all in the same town and range, may be recorded on this certificate.

- A. Description of original monument and accessories and/or subsequent restoration:  
 M-4 1817 W. PRESTON, GLO, SET POST  
 1) 1970, W. SODERBERG #17635, FND. RE-ROD, AEW RECORDS.  
 2) 1978, R. SMITH #16052, FND. 1/2" IRON, SURVEY L. 3055, P. 784, M.C.R.  
 3) 1978, R. SMITH #16052, FND. 1/2" IRON, LCRC L. 3055, P. 832, M.C.R.

ACCEPTED BY THE MACOMB COUNTY SURVEY PEER GROUP AS THE OFFICIAL CORNER UNDER MICHIGAN PUBLIC ACT 345 OF 1990 AT A MEETING HELD ON 8/27/98  
  
 WILLIAM E. SODERBERG, P.S., CHAIRMAN

- B. Description of corner evidence found and/or method applied in restoring or reestablishing corner:  
 M-4 FOUND 1/2" IRON WITH A DAMAGED CAP AT THE INTERSECTION OF GRAVEL ROADS STODDARD (NORTH) AND KRONER (EAST) AT THE SURFACE.

- 41.25' (2, 3) - N.E. - P.K. NAIL IN POWER POLE. (FND. 41.10')  
 40.00' (2, 3) - S.W. - P.K. NAIL IN POWER POLE. (FND. 40.15')  
 40.80' (2, 3) - N.W. - P.K. NAIL IN POWER POLE. (FND. 40.92')

FIELD MEASUREMENTS


- |  |  |
|--|--|
| M-4 TO M-3, GLO (1817) - 40 CHAINS (2640') | M-4 TO M-5, GLO (1817) - 40 CHAINS (2640') |
| NO PREVIOUS RECORDED DISTANCE              | NO PREVIOUS RECORDED DISTANCE              |
| RE-MONUMENTATION (1998) - 2667.86'         | RE-MONUMENTATION (1998) - 2661.06'         |

- C. Description of monument for corner and accessories established to perpetuate locating the position of the corner:  
 M-4 REPLACED 1/2" IRON WITH A 3/4" X 24" RE-BAR WITH A 2" DIAMETER ALUMINUM CAP STAMPED "MACOMB COUNTY MONUMENT, MI ACT 345, #41094, M-4".

- AZ. 0° - 130.91' - 1/2" IRON WITH DAMAGED CAP, A-4 COLUMBUS TOWNSHIP, ST. CLAIR COUNTY, T. 5N., R. 15 E.  
 AZ. 60° - 41.10' - SET MACOMB COUNTY RE-MON TAG IN NORTHWEST FACE UTILITY POLE AT FND P.K. NAIL.  
 AZ. 180° - 32.98' - FOUND 1/2" IRON WITH CAP #16052.  
 AZ. 230° - 40.15' - SET MACOMB COUNTY RE-MON TAG AT P.K. NAIL IN NORTHWEST FACE BRACED UTILITY POLE.  
 AZ. 300° - 40.92' - SET MACOMB COUNTY RE-MON TAG IN NORTHEAST FACE UTILITY POLE AT FND. P.K. NAIL.

THE SELECTED LOCATION IS ACCEPTED BY ME AND IS GENERALLY ACCEPTED BY PROFESSIONAL SURVEYORS AS THE BEST AVAILABLE EVIDENCE OF THE POSITION OF THE ORIGINAL CORNER.

Signed by Robert H. Birkett Date 11-24-98  
 Surveyor's Michigan License No. 41094

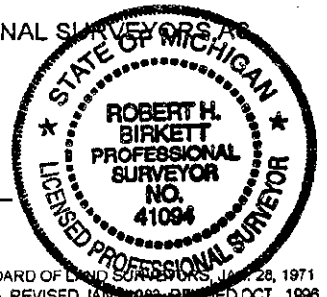

837