


LAND CORNER RECORDATION CERTIFICATE
 Filing Requirement of Act 74, Mich. P.A. 1970

For corners in

<u>MACOMB</u> (County)	RICHMOND TOWNSHIP	
	Located In:	Corner Code #
1. Public Land Survey	T <u>5 N</u> R <u>14 E</u>	<u>M-6</u>
	T _____ R _____	_____
	T _____ R _____	_____
	T _____ R _____	_____
2. Property Controlling in Section	S _____ T _____ R _____	_____
	S _____ T _____ R _____	_____
3. Miscellaneous Property in Sec.	S _____ T _____ R _____	_____
	S _____ T _____ R _____	_____

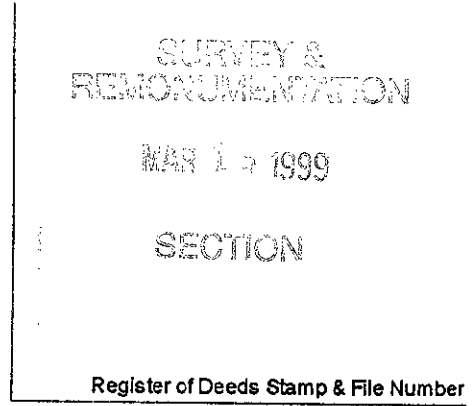

4. Lot No. _____, Recorded Plat _____
 5. Private Claims _____

I, ROBERT H. BIRKETT, in a field survey on APRIL 11, 1998 do hereby certify that under requirements of P.A. 74, Michigan P.A. of 1970, the corner points mentioned in lines 1 and 2 above were in conformance with regulations and rules therefore as required in the current manual of survey instructions of the United States Department of the Interior, Bureau of Land Management or by a decree of a Court of Law and /or that the corner points mentioned in lines 3, 4 and 5 above were in conformance with the rules of the Michigan Board of Land Surveyors or by a Decree of a Court of Law, established, re-established, monumented, re-monumented, recovered, found as expressed below:

NOTE: Not more than 2 corners, all in the same town and range, may be recorded on this certificate.

	A	B	C	D	E	F	G	H	I	J	K	L	M
1													
2	6		5		4		3		2		1		
3													
4	7		8		9		10		11		12		
5													
6	18		17		16		15		14		13		
7													
8	19		20		21		22		23		24		
9													
10	30		29		28		27		26		25		
11													
12	31		32		33		34		35		36		
13													

A. Description of original monument and accessories and/or subsequent restoration:
 M-6 . 1817 W. PRESTON, GLO, SET POST
 1) PROFESSIONAL ENGINEERING ASSOC., SET 1/2" IRON, FIELD NOTES.

ACCEPTED BY THE MACOMB COUNTY SURVEY PEER GROUP AS THE OFFICIAL CORNER UNDER MICHIGAN PUBLIC ACT 345 OF 1990 AT A MEETING HELD ON 9/29/98
William E. Soderberg
 WILLIAM E. SODERBERG, P.S., CHAIRMAN

B. Description of corner evidence found and/or method applied in restoring or reestablishing corner:
 M-6 SET CORNER AT THE INTERSECTION OF A LINE FROM M-5, RICHMOND TOWNSHIP, MACOMB COUNTY, THROUGH A-6, COLUMBUS TOWNSHIP, ST. CLAIR COUNTY AND A LINE AT RECORD BEARING FROM FOUND IRON MENTIONED IN SECTION "A".
 CALCULATED POSITION PLACES MONUMENTS IN A NOTH AND SOUTH FENCE IN POOR REPAIR.

FIELD MEASUREMENTS
 M-6 TO M-5, GLO (1817) - 40 CHAINS (2640') NO PREVIOUS RECORDED DISTANCES RE-MONUMENTATION (1998) - 2669.39'
 M-6 TO M-7, GLO (1817) - 40 CHAINS (2640') NO PREVIOUS RECORDED DISTANCES RE-MONUMENTATION (1998) - 2668.56'

C. Description of monument for corner and accessories established to perpetuate locating the position of the corner:
 M-6 SET 1/2" IRON ENCASED IN 4" CONCRETE WITH A 2" ALUMINUM CAP STAMPED "MACOMB COUNTY MONUMENT, MI ACT 345, #41094, M-6".

- AZ. 0° - 2.35' - SET MACOMB RE-MON TAG IN WEST FACE 8" ELM.
- AZ. 190° - 15.45' - SET MACOMB RE-MON TAG IN NORTH 10" BEECH.
- AZ. 285° - 30.98' - SET MACOMB RE-MON TAG IN NORTH FACE 12" BEECH.
- AZ. 300° - 32.00' - SET MACOMB RE-MON TAG IN WEST FACE 10" ASH.

THE SELECTED LOCATION IS ACCEPTED BY ME AND IS GENERALLY ACCEPTED BY PROFESSIONAL SURVEYORS AS THE BEST AVAILABLE EVIDENCE OF THE POSITION OF THE ORIGINAL CORNER.

Signed by Robert H. Birkett Date 11-24-98
 Surveyor's Michigan License No. 41094

