


**LAND CORNER RECORDATION CERTIFICATE**  
 Filing Requirement of Act 74, Mich. P.A. 1970

For corners in

<u>MACOMB</u> (County)	<b>RICHMOND TOWNSHIP</b>	Located In:	Corner Code #
1. Public Land Survey	T <u>5</u> N R <u>14</u> E		<u>M-7</u>
	T _____ R _____		_____
	T _____ R _____		_____
	T _____ R _____		_____
2. Property Controlling In Section	S _____ T _____ R _____		_____
	S _____ T _____ R _____		_____
3. Miscellaneous Property in Sec.	S _____ T _____ R _____		_____
	S _____ T _____ R _____		_____

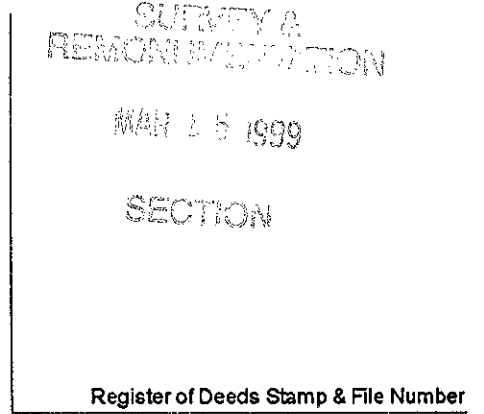

4. Lot No. \_\_\_\_\_, Recorded Plat \_\_\_\_\_  
 5. Private Claims \_\_\_\_\_

I, ROBERT H. BIRKETT, in a field survey on APRIL 11, 1998 do hereby certify that under requirements of P.A. 74, Michigan P.A. of 1970, the corner points mentioned in lines 1 and 2 above were in conformance with regulations and rules therefore as required in the current manual of survey instructions of the United States Department of the Interior, Bureau of Land Management or by a decree of a Court of Law and /or that the corner points mentioned in lines 3, 4 and 5 above were in conformance with the rules of the Michigan Board of Land Surveyors or by a Decree of a Court of Law; established, re-established, monumented, re-monumented, recovered, found as expressed below:

	A	B	C	D	E	F	G	H	I	J	K	L	M
1													
2		6		5		4		3		2		1	
3													
4		7		8		9		10		11		12	
5													
6		16		17		16		15		14		13	
7													
8		19		20		21		22		23		24	
9													
10		30		29		28		27		26		25	
11													
12		31		32		33		34		35		36	
13													

NOTE: Not more than 2 corners, all in the same town and range, may be recorded on this certificate.

A. Description of original monument and accessories and/or subsequent restoration:

- M-7 1817 W. PRESTON, GLO, SET POST  
 1) 1979, H. KOBBS #14097, FND. 1/2" IRON, L. 6(SUR), P. 316, S.C.C.R.  
 2) 1997, R. STECKER #30103, 1/2" IRON, UNRECORDED SURVEY.

ACCEPTED BY THE MACOMB COUNTY SURVEY PEER GROUP AS THE OFFICIAL CORNER UNDER MICHIGAN PUBLIC ACT 345 OF 1990 AT A MEETING HELD ON 9/29/98  
*William E. Soderberg*  
 WILLIAM E. SODERBERG, P.S., CHAIRMAN

B. Description of corner evidence found and/or method applied in restoring or reestablishing corner:

- M-7 FOUND 1/2" IRON WITH CAP #30103 AT THE INTERSECTION EXTENDED OF GRAVEL ROADS LOGG (WEST) AND STODDARD (SOUTH) NO DEPTH AT THE SOUTH BASE DIRECTIONAL ARROW SIGN.  
 59.92' (2) - SSW - P.K. & TAG IN 24" PINE. (FND. 60.00')  
 95.10' (2) - WSW - P.K. & TAG IN 18" PINE. (FND. 94.93')  
 72.65' (2) - NNW - P.K. & TAG IN 20" PINE. (FND. 72.40')  
 25.54' (1) - NNW - P.K. NAIL IN 9" PINE. (FND. 25.35')

FIELD MEASUREMENTS DISTANCE TO A-7, COLUMBUS TOWNSHIP, ST. CLAIR COUNTY - 100.2 +/-  
 M-7 TO M-6, GLO (1817) - 40 CHAINS (2640') M-7 TO M-8, GLO (1817) - 40 CHAINS (2640')  
 NO PREVIOUS RECORDED DISTANCE STECKER (1997) - 2673.71'  
 RE-MONUMENTATION (1998) - 2668.56' RE-MONUMENTATION (1998) - 2673.77'

C. Description of monument for corner and accessories established to perpetuate locating the position of the corner:  
 M-7 REPLACED CAPPED 1/2" IRON WITH AN 1/2" IRON ENCASED IN CONCRETE WITH A 2" DIAMETER ALUMINUM CAP STAMPED "MACOMB COUNTY MONUMENT, MI ACT 345, #41094, M-7".

- AZ. 205° - 60.00' - P.K. NAIL W/TAG # 30103 EAST FACE 15" SPRUCE PINE.  
 AZ. 245° - 94.93' - P.K. NAIL W/TAG #30103 NORTHWEST FACE 15" PINE.  
 AZ. 290° - 72.40' - P.K. NAIL W/TAG # 14864 IN SOUTH FACE 21" PINE.  
 AZ. 340° - 25.35' - P.K. NAIL IN WEST FACE 10" PINE.

THE SELECTED LOCATION IS ACCEPTED BY ME AND IS GENERALLY ACCEPTED BY PROFESSIONAL SURVEYORS AS THE BEST AVAILABLE EVIDENCE OF THE POSITION OF THE ORIGINAL CORNER.

Signed by Robert H. Birkett Date 11-24-98  
 Surveyor's Michigan License No. 41094

