

LAND CORNER RECORDATION CERTIFICATE
 Filing Requirement of Act 74, Mich. P.A. 1970

For corners in

RICHMOND TOWNSHIP
 Located In: Corner Code #

MACOMB
 (County)

- | | | | |
|------------------------------------|-------|---------------------|------------|
| 1. Public Land Survey | | <u>T 5 N R 14 E</u> | <u>M-9</u> |
| | | T ___ R ___ | _____ |
| | | T ___ R ___ | _____ |
| | | T ___ R ___ | _____ |
| 2. Property Controlling in Section | S ___ | T ___ R ___ | _____ |
| | S ___ | T ___ R ___ | _____ |
| 3. Miscellaneous Property in Sec. | S ___ | T ___ R ___ | _____ |
| | S ___ | T ___ R ___ | _____ |

SURVEY &
 RE-MONUMENTATION

MAR 15 1999

SECTION

Register of Deeds Stamp & File Number

4. Lot No. _____, Recorded Plat _____
 5. Private Claims _____

I, ROBERT H. BIRKETT, in a field survey on JUNE 8, 1998 do hereby certify that under requirements of P.A. 74, Michigan P.A. of 1970, the corner points mentioned in lines 1 and 2 above were in conformance with regulations and rules therefore as required in the current manual of survey instructions of the United States Department of the Interior, Bureau of Land Management or by a decree of a Court of Law and/or that the corner points mentioned in lines 3, 4 and 5 above were in conformance with the rules of the Michigan Board of Land Surveyors or by a Decree of a Court of Law, established, re-established, monumented, re-monumented, recovered, found as expressed below:

NOTE: Not more than 2 corners, all in the same town and range, may be recorded on this certificate.

A	B	C	D	E	F	G	H	I	J	K	L	M
1												
2	6	5	4	3	2	1						
3												
4	7	8	9	10	11	12						
5												
6	18	17	16	15	14	13						
7												
8	19	20	21	22	23	24						
9												
10	30	29	28	27	26	25						
11												
12	31	32	33	34	35	36						
13												


A. Description of original monument and accessories and/or subsequent restoration:

SEE BACK

B. Description of corner evidence found and/or method applied in restoring or reestablishing corner:

M-9 FOUND 1/2" IRON IN THE CENTER OF GRAVEL DRIVE AT THE INTERSECTION (EXTENDED) OF GRAVEL STODDARD (NORTH) AND GRAVEL BIG HAND (WEST) AT A DEPTH OF 0.3', 1' +/- WEST OF A 12" CMP DRIVE CULVERT.

- 37.3' (1) - S.W. - NORTH SIDE SIGN POST. (FND. 37.4')
- 76.73' (2, 3, 6) - EAST - S.W. CORNER FRAME GARAGE.. (FND. 76.76')
- 42.45' (4) - S.W. - SPIKE & CAP IN D.E. POLE. (FND. 42.46')

ACCEPTED BY THE MACOMB COUNTY SURVEY PEER GROUP AS THE OFFICIAL CORNER UNDER MICHIGAN PUBLIC ACT 345 OF 1990 AT A MEETING HELD ON 8/27/98

 WILLIAM E. SODERBERG, P.S., CHAIRMAN

FIELD MEASUREMENTS

- | | |
|-------------------------------------|--------------------------------------|
| M-9 TO M-8, GLO - 40 CHAINS (2640') | M-9 TO M-10, GLO - 40 CHAINS (2640') |
| MELCHING (1971) - 2610.10' | KREGER (1982) - 2672.96' |
| LANSKY (1977 & 1980) - 2682.00' | RE-MONUMENTATION (1998) - 2672.98' |
| RE-MONUMENTATION (1998) - 2682.24' | |


C. Description of monument for corner and accessories established to perpetuate locating the position of the corner:

M-9 REPLACED 1/2" IRON WITH A 3/4" X 24" RE-BAR WITH A 2" DIAMETER ALUMINUM CAP STAMPED "MACOMB COUNTY MONUMENT, MI ACT 345, #41094, M-9".

- AZ. 55° - 17.80' - SET MACOMB COUNTY RE-MON TAG IN NORTHWEST FACE 28" POPULAR.
- AZ 105° - 76.76' - FOUND BLOCK SOUTH WEST CORNER OF ATTACHED GARAGE #2005.
- AZ. 220° - 42.46' - FOUND P.K. NAIL WITH TAG (NO NUMBER) IN NORTHEAST FACE UTILITY POLE.
- AZ. 250° - 37.4' - FOUND NORTHMOST LEG OF DOUBLE ARROW SIGN.
- AZ. 335° - 85.75' - SET MACOMB COUNTY RE-MON TAG IN SOUTHEAST FACE UTILITY POLE.

THE SELECTED LOCATION IS ACCEPTED BY ME AND IS GENERALLY ACCEPTED BY PROFESSIONAL SURVEYORS AS THE BEST AVAILABLE EVIDENCE OF THE POSITION OF THE ORIGINAL CORNER.

Signed by Robert H. Birkett Date 11-24-98
 Surveyor's Michigan License No. 41094

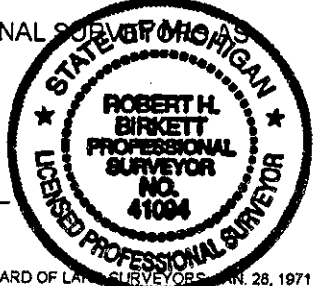

842

SURVEY &
REMONUMENTATION

MAR 15 1999

SECTION

A. Description of original monument and accessories and/or subsequent restoration:

FROM FRONT

M-9 1817, W. PRESTON, GLO, SET POST

- 1) 1971-1973, C. MELCHING #14767, SQUARE BOLT, SURVEYS L 2285, P. 423, 425-426 M.C.R.
LC.R.C. L 2285, P. 449, M.C.R.
SURVEY L 2428, P. 146, M.C.R.
- 2) 1971-1972, H. KOBBS #14097, 3/4" STEEL BOLT, SURVEY L 2268, P. 619 M.C.R.
LC.R.C. L 2262, P. 642, M.C.R.
- 3) 1977, J. LANSKY #18659, BOLT, SURVEY L 2875, P. 700, M.C.R.
- 4) 1980, J. LANSKY #18659, SQUARE BOLT, SURVEY L 3216, P. 625, M.C.R.
- 5) 1982, R. KREGER #24601, NOT STATED, SURVEY L 3407, P. 788 M.C.R.
- 6) 1983, H. KOBBS #14097, 3/4" STEEL BOLT, SURVEY L 3532, P. 259, M.C.R.

C0863660 LIBER:08565 PAGE:901 09:45A 01/19/1999
CARMELLA SABAUGH-MACOMB COUNTY, MI REG/DEEDS