

LAND CORNER RECORDATION CERTIFICATE
 Filing Requirement of Act 74, Mich. P.A. 1970

For corners in

MACOMB
 (County)

RICHMOND TOWNSHIP
 Located In: Corner Code #

**SURVEY &
 RE-MONUMENTATION**

MAR 15 1999

SECTION

Register of Deeds Stamp & File Number

- | | | | |
|------------------------------------|-------|---------------------|-------------|
| 1. Public Land Survey | | <u>T 5 N R 14 E</u> | <u>M-10</u> |
| | | T ___ R ___ | _____ |
| | | T ___ R ___ | _____ |
| | | T ___ R ___ | _____ |
| 2. Property Controlling in Section | S ___ | T ___ R ___ | _____ |
| | S ___ | T ___ R ___ | _____ |
| 3. Miscellaneous Property in Sec. | S ___ | T ___ R ___ | _____ |
| | S ___ | T ___ R ___ | _____ |

4. Lot No. _____, Recorded Plat _____
 5. Private Claims _____

I, ROBERT H. BIRKETT, in a field survey on JUNE 5, 1998 do hereby certify that under requirements of P.A. 74, Michigan P.A. of 1970, the corner points mentioned in lines 1 and 2 above were in conformance with regulations and rules therefore as required in the current manual of survey instructions of the United States Department of the Interior, Bureau of Land Management or by a decree of a Court of Law and /or that the corner points mentioned in lines 3, 4 and 5 above were in conformance with the rules of the Michigan Board of Land Surveyors or by a Decree of a Court of Law; established, re-established, monumented, re-monumented, recovered, found as expressed below:

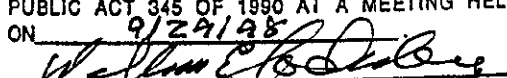
NOTE: Not more than 2 corners, all in the same town and range, may be recorded on this certificate.

	A	B	C	D	E	F	G	H	I	J	K	L	M
1													
2	6		5		4		3		2		1		
3													
4	7		8		9		10		11		12		
5													
6	18		17		16		15		14		13		
7													
8	19		20		21		22		23		24		
9													
10	30		29		28		27		26		25		
11													
12	31		32		33		34		35		36		
13													

A. Description of original monument and accessories and/or subsequent restoration:
SEE BACK

B. Description of corner evidence found and/or method applied in restoring or reestablishing corner:
 FOUND 1/2" IRON WITH CAP #19835 AT THE APPROXIMATE CENTER OF A 50' +/- WIDE TREE ROW TO THE SOUTH, WOODS TO THE NORTH.

- 1) 2.5' S, TO SPIKE 8" OAK. (FND. 2.60')
- 2) 2.4' SOUTH SPIKE IN 30" OAK. (FND. 2.60')
- 3) SOUTH 2.60' TO P.K. NAIL IN EAST SIDE 24" MAPLE. (FND. 2.60')
- 1, 2) 22.91' TO CHISELED "X" IN 4' DIA. BOULDER. (FND. 22.52')
- 3) S.W. 17.98' TO P.K. NAIL IN EAST SIDE 8" ELM. (FND. 18.00')
- 3) WEST 23.62' TO P.K. NAIL IN NORTH SIDE 8" ASH. (FND. 23.60')
- 3) NORTH 20.48' TO P.K. NAIL IN EAST SIDE 18" ELM. (FND. 20.43')

ACCEPTED BY THE MACOMB COUNTY SURVEY PEER GROUP AS THE OFFICIAL CORNER UNDER MICHIGAN PUBLIC ACT 345 OF 1990 AT A MEETING HELD ON 9/29/98

 WILLIAM E. SODERBERG, P.S., CHAIRMAN

FIELD MEASUREMENTS

M-10 TO M-9, GLO - 40 CHAINS (2640')
 KREGER (1983) - 2672.60'
 RE-MONUMENTATION (1998) - 2672.98'

M-10 TO M-11, GLO - 40 CHAINS (2640')
 JAMES (1992) - 2648.45'
 NIEDERHAUSER (1996) - 2653.14'
 RE-MONUMENTATION (1998) - 2647.64'

C. Description of monument for corner and accessories established to perpetuate locating the position of the corner:
 M-10 CAPPED EXISTING CONCRETE MONUMENT WITH A 2" DIAMETER ALUMINUM CAP STAMPED "MACOMB COUNTY MONUMENT, MI ACT 345, #41094, M-10".

- AZ. 15° - 20.43' - FOUND P.K. NAIL IN SOUTHEAST FACE 8" ELM.
- AZ. 140° - 2.50' - FOUND SPIKE IN NORTHEAST FACE 24" STUMP.
- AZ. 210° - 18.00' - SET MACOMB COUNTY RE-MON TAG OVER FOUND P.K. NAIL IN SOUTHEAST FACE 6" OAK.
- AZ. 245° - 22.52' - FOUND CHISELED "X" AT NORTHEAST QUADRANT OF A 4' DIAMETER BOULDER.
- AZ. 255° - 23.60' - SET MACOMB COUNTY RE-MON TAG IN NORTHEAST FACE 8" ELM.

THE SELECTED LOCATION IS ACCEPTED BY ME AND IS GENERALLY ACCEPTED BY PROFESSIONAL SURVEYORS AS THE BEST AVAILABLE EVIDENCE OF THE POSITION OF THE ORIGINAL CORNER.

Signed by Robert H. Birkett Date 11-24-98
 Surveyor's Michigan License No. 41094



843

A. Description of original monument and accessories and/or subsequent restoration:

FROM FRONT

SURVEY &
RECONSTRUCTION

1817 W. PRESTON, GLO, SET POST

SIAP 15 1999

1) 1975, 1978, 1992, G. JAMES #19835, 1/2" RE-ROD (SET CAP #19835), SURVEY L 2595, P. 840, M.C.R.

SURVEY L 2615, P. 24, M.C.R.

SURVEY L 2925, P. 467, M.C.R.

SURVEY L 5601, P. 110, M.C.R.

SECTION

2) 1982, R. KREGER #24601, NOT STATED, L 3407, P. 788, M.C.R.

3) 1996, J. NIEDERHAUSER #24608, 1/2" ROD CAP #19835, L.C.R.C. L 7035, P. 826.

C0863661 LIBER:08565 PAGE:903 09:45A 01/19/1999
CARMELLA SABAUGH-MACOMB COUNTY, MI REG/DEEDS