

LAND CORNER RECORDATION CERTIFICATE
 Filing Requirement of Act 74, Mich. P.A. 1970

For corners in

RICHMOND TOWNSHIP
 Located in: Corner Code #

MACOMB
 (County)

- | | | |
|------------------------------------|----------------------------|-------------|
| 1. Public Land Survey | T <u>5</u> N R <u>14</u> E | <u>M-12</u> |
| | T ___ R ___ | _____ |
| | T ___ R ___ | _____ |
| | T ___ R ___ | _____ |
| 2. Property Controlling in Section | S ___ T ___ R ___ | _____ |
| | S ___ T ___ R ___ | _____ |
| 3. Miscellaneous Property in Sec. | S ___ T ___ R ___ | _____ |
| | S ___ T ___ R ___ | _____ |

SURVEY &
 REMONUMENTATION

MAR 15 1999

SECTION

Register of Deeds Stamp & File Number

4. Lot No. _____, Recorded Plat _____
 5. Private Claims _____


I, ROBERT H. BIRKETT, in a field survey on JUNE 8, 1998 do hereby certify that under requirements of P.A. 74, Michigan P.A. of 1970, the corner points mentioned in lines 1 and 2 above were in conformance with regulations and rules therefore as required in the current manual of survey instructions of the United States Department of the Interior, Bureau of Land Management or by a decree of a Court of Law and for that the corner points mentioned in lines 3, 4 and 5 above were in conformance with the rules of the Michigan Board of Land Surveyors or by a Decree of a Court of Law, established, re-established, monumented, re-monumented, recovered, found as expressed below:

NOTE: Not more than 2 corners, all in the same town and range, may be recorded on this certificate.

	A	B	C	D	E	F	G	H	I	J	K	L	M
1													
2	6		5		4		3		2		1		
3													
4	7		8		9		10		11		12		
5													
6	18		17		16		15		14		13		
7													
8	19		20		21		22		23		24		
9													
10	30		29		28		27		26		25		
11													
12	31		32		33		34		35		36		
13													

A. Description of original monument and accessories and/or subsequent restoration:

- M-12 1817 W. PRESTON, GLO, SET POST
 1) 1989, J. LANSKY #18659, CALCULATED CORNER, L. 4766, P. 543, M.C.R.

ACCEPTED BY THE MACOMB COUNTY SURVEY PEER GROUP AS THE OFFICIAL CORNER UNDER MICHIGAN PUBLIC ACT 345 OF 1990 AT A MEETING HELD ON 10/27/1989

 WILLIAM E. SODERBERG, P.S., CHAIRMAN

B. Description of corner evidence found and/or method applied in restoring or reestablishing corner:

- M-12 NO CORNER FOUND.
 CALCULATED CORNER USING INFORMATION PROVIDED IN SURVEY BY J. LANSKY, AS RECORDED IN LIBER 4766, PAGE 543, MACOMB COUNTY RECORDS.
 WOVEN WIRE FENCE IN LOCATED 1.2' WEST (NORTH AND SOUTH) OF CALCULATED CORNER WITH A TREE LINE ALSO TO THE WEST

FIELD MEASUREMENTS

- | | |
|--|--|
| M-12 TO M-11, GLO (1817) - 40 CHAINS (2640') | M-12 TO M-13, GLO (1817) - 40 CHAINS (2640') |
| NO PREVIOUS RECORDED DISTANCE. | J. LANSKY (CALC. 1989) - 2715.50' |
| RE-MONUMENTATION (1998) - 2700.69' | RE-MONUMENTATION (1998) - 2715.49' |


C. Description of monument for corner and accessories established to perpetuate locating the position of the corner:

- M-12 SET AN 1/2" IRON ENCASED IN CONCRETE WITH A 2" DIAMETER ALUMINUM CAP STAMPED "MACOMB COUNTY MONUMENT, MI ACT 345, #41094, M-12".

- AZ. 30° - 11.20' - SET MACOMB COUNTY RE-MON TAG IN WEST FACE 15" ELM.
 AZ. 145° - 11.22' - SET MACOMB COUNTY RE-MON TAG IN SOUTHWEST FACE 5" IRON WOOD.
 AZ. 275° - 11.78' - SET MACOMB COUNTY RE-MON TAG IN SOUTH FACE 6" IRON WOOD.
 AZ. 310° - 10.09' - SET MACOMB COUNTY RE-MON TAG IN SOUTHWEST FACE 10" ELM.
 AZ. 350° - 15.5' - CENTER 2' DIAMETER ROCK.

THE SELECTED LOCATION IS ACCEPTED BY ME AND IS GENERALLY ACCEPTED BY PROFESSIONAL SURVEYORS AS THE BEST AVAILABLE EVIDENCE OF THE POSITION OF THE ORIGINAL CORNER.

Signed by Robert H. Birkett Date 11-24-98
 Surveyor's Michigan License No. 41094

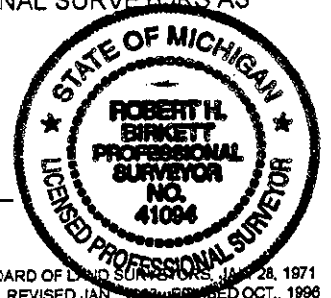

845