

# LAND CORNER RECORDATION CERTIFICATE

## FILING REQUIREMENT OF ACT 74, MICH. P.A.1970

FOR CORNERS OF--:	LOCATED IN--:	CORNER CODE NUMBER
1. PUBLIC LAND SURVEY _____	T. <u>21</u> N. <u>●</u> , R. <u>15</u> W. <u>●</u>	D-9; E-9; E-10; E-11
2. PROPERTY CONTROLLING IN SECTION _____	, T. _____ S., R. _____ E. W.	_____
3. MISCELLANEOUS PROPERTY IN SECTION _____	, T. _____ S., R. _____ E. W.	_____
4. LOT NO. _____, RECORDED PLAT _____		
5. PRIVATE CLAIMS _____		

REGISTER OF DEEDS STAMP AND FILING NUMBER \_\_\_\_\_

I, Carl F. Roser, do hereby certify that under requirements of P.A. 74, Michigan P.A. of 1970, the corner points mentioned in lines 1 and 2 above were, in a field survey on September 2, 1975, established, re-established, monumented, re-monumented, recovered or restored as expressed below and in conformance with regulations and rules therefore as required in the current manual of survey instructions of the United States Department of the Interior, Bureau of Land Management or by a decree of a court of law. Furthermore, that the corner points mentioned in lines 3, 4 and 5 above were, in a field survey on \_\_\_\_\_, 19\_\_\_\_, found, recovered, restored, established or re-established as expressed below and in conformance with the rules of the Michigan State Board of Registration for Land Surveyors or, by a Decree of a Court of law:

A. Description of original monument and accessories and of subsequent restoration

C. (continued)

E-11		
Fd. & accepted 2 1/4"x36" pipe & added cedar post w/loc. tag		
2" W. Pine	N60°W	25.6
11" Oak	N50°E	54.2
3" W. Oak	S35°W	26.8
Random N	Due W	34'

B. Description of corner evidence found and/or method applied in restoring or re-establishing corner:

- D-9 Recovered large stone in old E-W dirt road. W.D. Manchester's notes call for large stone and roots of both U.S.B.T.'s.
- E-9 Found large spike in N-S b'top road in line with center of trail roads to E & W, per previous survey by R.L.S. T. Slawinski. A corner position by Manchester witness (still standing) date 1929, would be 5' E.
- E-10 Restored quarter corner from two Manchester witnesses, still standing, dated 1929.
- E-11 Found pipe & two remaining witnesses from survey by Sam Walker, dated 1949.

C. Description of monument for corner and accessories established to perpetuate locating the position of the corner:

D-9	E-9	E-10
Fd. stone added DNR mon. buried	Fd. spike & added 1 1/4"x22" iron pin	Set 1/2"x3/8"x20" iron
5" W. Pine S45°W 30.2	5" J. Pine N68°W 64.02	5" W. Oak N48°W 40.2
5" W. Pine S80°W 62.2	11" J. Pine N33°E 85.25	13" W. Oak S80°W 37.9
10" B. Oak N10°E 32.9	10" J. Pine S60°E 62.20	Spike, curve PT
Set cedar post w/loc. tag	Set cedar post w/loc. tag	Due S 188.50
Due S 33'	S45°E 50'	Set ced.post w/loc. tag
		Due W 33'
		⊥ N-S bit. road
		Due E 3'


SIGNED BY Carl F. Roser 9-15-76 DATE \_\_\_\_\_

SURVEYOR'S MICHIGAN REGISTRATION NO. 12028

FOR STATE AND UNITED STATES AGENCIES:

SIGNED BY \_\_\_\_\_ DATE \_\_\_\_\_

APPROVED AND SIGNED BY \_\_\_\_\_ DATE \_\_\_\_\_

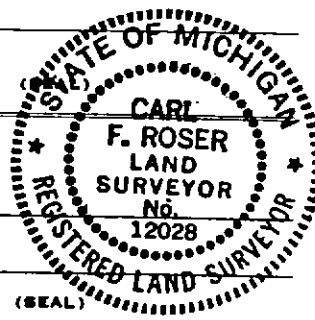

SURVEYOR'S MICHIGAN REGISTRATION NO. \_\_\_\_\_ STRONACH TOWNSHIP  
MANISTEE COUNTY

MAY PLACE SKETCH ON BACK OR ATTACHED SHEET