

# LAND CORNER RECORDATION CERTIFICATE

## FILING REQUIREMENT OF ACT 74, MICH. P.A.1970

FOR CORNERS OF--:	LOCATED IN--:	CORNER CODE NUMBER
1. PUBLIC LAND SURVEY _____	T. <u>21</u> <sup>N.</sup> <u>15</u> <sup>R.</sup>	<u>B-13</u>
2. PROPERTY CONTROLLING IN SECTION <u>30</u>	T. <u>21</u> <sup>N.</sup> <u>15</u> <sup>R.</sup>	<u>3; 15</u>
3. MISCELLANEOUS PROPERTY IN SECTION _____	T. _____ <sup>N.</sup> _____ <sup>R.</sup> _____ <sup>E.</sup> _____ <sup>W.</sup> _____	_____
4. LOT NO. _____, RECORDED PLAT _____		
5. PRIVATE CLAIMS _____		

REGISTER OF DEEDS STAMP AND FILING NUMBER

I, Carl F. Roser, do hereby certify that under requirements of P.A. 74, Michigan P.A. of 1970, the corner points mentioned in lines 1 and 2 above were, in a field survey on November 4, 1975, established, re-established, monumented, re-monumented, recovered or restored as expressed below and in conformance with regulations and rules therefore as required in the current manual of survey instructions of the United States Department of the Interior, Bureau of Land Management or by a decree of a court of law. Furthermore, that the corner points mentioned in lines 3, 4 and 5 above were, in a field survey on \_\_\_\_\_, 19\_\_\_\_, found, recovered, restored, established or re-established as expressed below and in conformance with the rules of the Michigan State Board of Registration for Land Surveyors or, by a Decree of a Court of law:

A. Description of original monument and accessories and/or subsequent restoration:

B. Description of corner evidence found and/or method applied in restoring or re-establishing corner:


- B-13** Found U.S.F.S. concrete monument for S $\frac{1}{4}$  corner, Section 31.
- 3** Found and accepted concrete monument as previously established by R.L.S. Ken Ross.
- 15** Reestablished W 1/16 on S line Sec. 30 on line between section corners to E & W and at prorated distance to G.L.O. survey.

C. Description of monument for corner and accessories established to perpetuate locating the position of the corner:

B-13	3	15
Found F.S. conc. monument	Found & accepted conc. mon.	Set 1 $\frac{1}{2}$ "x30" pipe & cedar post
7" W. Oak N20 <sup>0</sup> W 59.60	added ced. post w/loc. tag	w/loc. tag
6" B. Oak N03 <sup>0</sup> W 90.13	4" W. Pine N65 <sup>0</sup> E 18.7	13" R. Pine S70 <sup>0</sup> E 41.9
5" W. Oak N60 <sup>0</sup> E 99.05	5" W. Oak S03 <sup>0</sup> E 14.3	10" Maple S02 <sup>0</sup> W 12.1
4"x7' post Due N 33'		Found 1" pipe S87 <sup>0</sup> W 7.74

SIGNED BY Carl F. Roser 9-15-76 DATE \_\_\_\_\_

SURVEYOR'S MICHIGAN REGISTRATION NO. 12028

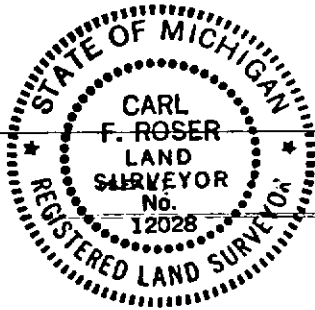

FOR STATE AND UNITED STATES AGENCIES:

SIGNED BY \_\_\_\_\_ DATE \_\_\_\_\_

CHIEF OF SURVEY PARTY

APPROVED AND SIGNED BY \_\_\_\_\_ DATE \_\_\_\_\_

MICHIGAN REGISTERED LAND SURVEYOR

(SEAL)

SURVEYOR'S MICHIGAN REGISTRATION NO. \_\_\_\_\_

STRONACH TOWNSHIP  
MANISTEE COUNTY