

**LAND CORNER RECORDATION CERTIFICATE**

Filing Requirement of Act 74, Mich. P.A. 1970

SECTION

For corners in

MANISTEE  
(County)

Located In:

Corner Code #

1. Public Land Survey	T 21 N R 16 W	M-6
	T 21 N R 15 W	A-6 ✓
	T _____ R _____	_____
	T _____ R _____	_____
2. Property Controlling in Section	S _____ T _____ R _____	_____
	S _____ T _____ R _____	_____
3. Miscellaneous Property in Sec.	S _____ T _____ R _____	_____
	S _____ T _____ R _____	_____

**REGISTER'S OFFICE  
MANISTEE COUNTY**

97-401 at 4:00pm  
**OCT 24 1997**

*Deborah Dix*

**REGISTER OF DEEDS**

Register of Deeds Stamp & File Number

4. Lot No. \_\_\_\_\_, Recorded Plat \_\_\_\_\_  
5. Private Claims \_\_\_\_\_

I, Sammy S. Barnett, in a field survey on Aug. 22nd 19 97, do hereby certify that under requirements of P.A. 74, Michigan P.A. of 1970, the corner points mentioned in lines 1 and 2 above were in conformance with regulations and rules therefore as required in the current manual of survey instructions of the United States Department of the Interior, Bureau of Land Management or by a decree of a Court of Law and/or that the corner points mentioned in lines 3, 4 and 5 above were in conformance with the rules of the Michigan Board of Land Surveyors or by a Decree of a Court of Law; established, re-established, monumented, re-monumented, recovered, found as expressed below:

**NOTE: Not more than 4 corners, all in the same town and range, may be recorded on this certificate.**

	A	B	C	D	E	F	G	H	I	J	K	L	M
1													
2	6		5		4		3		2		1		
3													
4	7		8		9		10		11		12		
5													
6	18		17		16		15		14		13		
7													
8	19		20		21		22		23		24		
9													
10	30		29		28		27		26		25		
11													
12	31		32		33		34		35		36		
13													

**A. Description of original monument and accessories and/or subsequent restoration:**

M - 6 Corner common to section 18 T21N R16W & section 13 T21N R15W

1837 GLO survey by John Brink Monument - Post  
# 1 W. Oak 8" S35W 47 lks (31.02')  
# 2 W. Pine 18" N49W 65 lks (42.90')  
40.64 cross line of reserve

1977 survey by Sam Barnett set 1/2" capped rebar onehalf way between M - 5 and M - 7 and on line between the Indian reserve corner and M - 7  
# 3 Indian reserve corner North 41.75'

**B. Description of corner evidence found and/or method applied in restoring or reestablishing corner:**

M - 6 Corner common to section 18 T21N R16W & section 13 T21N R15W

On August 22nd 1997, I found the capped rebar 41.75' South of the Indian reserve corner, Condition of the witnesses are as follows.

# 1 Gone # 2 Gone # 3 Found USFS concrete monument 41.75' North


**C. Description of monument for corner and accessories established to perpetuate locating the position of the corner:**

M - 6 Corner common to section 18 T21N R16W & section 13 T21N R15W

On August 22nd 1997, I replaced, in the exact location, the found 1/2" capped rebar with a Manistee County Monument, and accepted this location as a careful and faithful re-establishment of the position of the original corner, and took the following witnesses.

# 4 USFS concrete monument North 41.75' on Indian Reserve line  
# 5 W. Pine 6" N83E 50.00' placed a 60d spike in the North side  
# 6 W. Pine 6" S60E 49.93' placed a 60d spike in the Northeast side  
# 7 R. Pine 6" S82W 23.24' placed a 60d spike in the South side

Centerline of dirt road is 20' + - East  
Top of monument is set flush with the ground surface

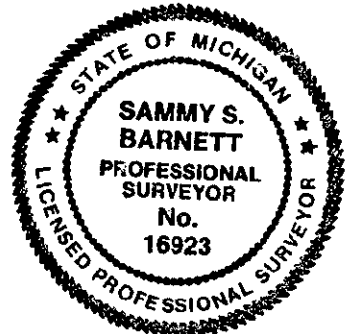

Signed by Sammy S. Barnett Date 10-17-97

Surveyor's Michigan License No. PS # 16923

Corner M-26 ratified by the Manistee County Peer Group according to the county plan adopted pursuant to P.A. 345 of 1990, as amended, (being the State Survey and Remonument Act, MCL 54.261 et seq.). Date of Peer Review: OCT 7 1997