

RE

SECTION

LAND CORNER RECORDATION CERTIFICATE

Filing Requirement of Act 74, Mich. P.A. 1970

For corners in

Manistee (County)

Located in:

Corner Code

1. Public Land Survey

T 21 N R 16 W

T 21 N R 15 W

T R

T R

2. Property Controlling in Section

S T R

S T R

3. Miscellaneous Property in Sec.

S T R

S T R

M-12
A-12 ✓

REGISTER'S OFFICE
MANISTEE COUNTY

97-405 at 4:20pm

OCT 24 1997

Rebecca Six
REGISTER OF DEEDS

Register of Deeds Stamp & File Number

4. Lot No. Recorded Plat
5. Private Claims

I, Sammy S. Barnett, in a field survey on August 22th 19 97, do hereby certify that under requirements of P.A. 74, Michigan P.A. of 1970, the corner points mentioned in lines 1 and 2 above were in conformance with regulations and rules therefore as required in the current manual of survey instructions of the United States Department of the Interior, Bureau of Land Management or by a decree of a Court of Law and/or that the corner points mentioned in lines 3, 4 and 5 above were in conformance with the rules of the Michigan Board of Land Surveyors or by a Decree of a Court of Law; established, re-established, monumented, re-monumented, recovered, found as expressed below:

Table with 13 rows and 13 columns (A-M) containing numbers 1-36.

NOTE: Not more than 4 corners, all in the same town and range, may be recorded on this certificate.

A. Description of original monument and accessories and/or subsequent restoration:

M - 12 ONE-QUARTER CORNER COMMON TO SECTION 36, T21N R16W & SECTION 31, T21N R15W

1837 GLO Survey by John Brink Monument - Post

1918 survey by T. Nozlin, found stake

1971 Robert Griffin # 13584 set USFS monument at location of found rotted wood stake.

1 Y. Pine 16" S71W 37 lks (24.42')
2 Y Pine 14" N72W 2.93 lks (1.93')

3 W. Oak 15" N4W 29.0'
4 W. Oak no size N81 1/2 E 50.0'

5 N.P. stp. 15" S61 1/2 W 25.0' (O.B.T.) (# 1)

6 W. Oak 5" N77E 25.64'
7 4x7 post 8 1.6'
8 R. Pine 2" S57W 31.44'
9 R. Pine 3" N64W 44.00'
Griffin found # 1 witness

B. Description of corner evidence found and/or method applied in restoring or reestablishing corner:

M - 12 ONE-QUARTER CORNER COMMON TO SECTION 36, T21N R16W & SECTION 31, T21N R15W

On August 22th 1997 I found the 5" square concrete monument set by R. A. Griffin, condition of the witnesses are as follows.

1 Gone # 2 Gone # 3 Found good condition # 4 Gone # 5 Gone # 6 Found # 7 Found # 8 Found # 9 Found

C. Description of monument for corner and accessories established to perpetuate locating the position of the corner:

M - 12 ONE-QUARTER CORNER COMMON TO SECTION 36, T21N R16W & SECTION 31, T21N R15W

On August 22th 1997 I accepted the found 5" square concrete monument set by R. A. Griffin as a careful and faithful perpetuation of the original corner and took the following witnesses.


10 W. Oak 6" N77E 25.64' Dock spike in North side (# 6)
11 4"x7' wood post Due South 1.6' no nail (# 7)
12 R. Pine 5" S57W 31.45' Dock spike in Southeast side (# 8)
13 R. Pine 8" N64W 44.00' Dock spike in South side (# 9)

Corner is located approximately 800' North of the road and extends 18" +- out of the ground

Signed by Sammy S. Barnett

Date 10-17-97

Surveyor's Michigan License No. P S # 16923

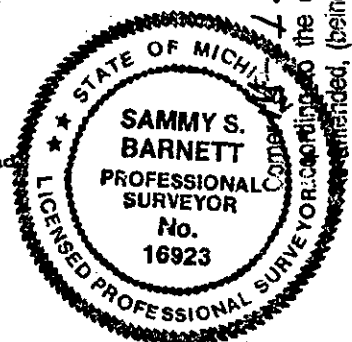

ratified by the Manistee County Peer Group pursuant to P.A. 345 of 1993, (being the State Survey and Monument Act, MCL 54.251 et. seq.). Date of Peer Review: 7-1997