

LAND CORNER RECORDATION CERTIFICATE
Filing Requirement of Act 74, Mich. P.A. 1970

For corners in Manistee Located In: _____ Corner Code # _____
 (County)

1. Public Land Survey T 21N R 15W _____ B-13
 T _____ R _____
 T _____ R _____
 T _____ R _____

2. Property Controlling S _____ T _____ R _____
 in Section S _____ T _____ R _____

3. Miscellaneous S _____ T _____ R _____
 Property in Sec. S _____ T _____ R _____

4. Lot No. _____, Recorded Plat _____

5. Private Claims _____

REGISTER'S OFFICE
MANISTEE COUNTY
 97-181 at 4:30pm
JUN 10 1997
Reborah Six
REGISTER OF DEEDS

Register of Deeds Stamp & File Number

I, Richard L. Hays, in a field survey on April 1997, do hereby certify that under requirements of P.A. 74, Michigan P.A. of 1970, the corner points mentioned in lines 1 and 2 above were in conformance with regulations and rules therefore as required in the current manual of survey instructions of the United States Department of the Interior, Bureau of Land Management or by a decree of a Court of Law and/or that the corner points mentioned in lines 3, 4 and 5 above were in conformance with the rules of the Michigan Board of Land Surveyors or by a Decree of a Court of Law; established, re-established, monumented, re-monumented, recovered, found as expressed below:

NOTE: Not more than 4 corners, all in the same town and range, may be recorded on this certificate.

A. Description of original monument and accessories and/or subsequent restoration:

B-13 SOUTH QUARTER CORNER OF SECTION 31, T21N-R15W
 1837: G.L.O Post 1971: Robert Griffin #13584, LCRC #72-20, #73-36
 Post in mound of earth & sod Established Corner from Norlin Notes. Set
 Pit East 10 lks (1) USFS Monument.
 5" White Oak N-55°-E 99.05' (2)
 7" White Oak N-20°-W 59.60' (3)
 6" Black Oak N-03°-W 90.13' (4)
 Pine Post North 33.02' (5)

1918: Theodore Norlin
 No Witnesses
 Peg for Corner 2640' west of Section Corner.

1976: Carl Rorer #12028 LCRC #77-10.
 Found USFS Monument.
 5" White Oak N-55°-E 99.05' (6)
 7" White Oak N-20°-W 59.60' (7)
 6" Black Oak N-03°-W 90.13' (8)
 Pine Post North 33.02' (9)

B. Description of corner evidence found and/or method applied in restoring or reestablishing corner:

B-13 SOUTH QUARTER CORNER OF SECTION 31, T21N-R15W
 April 1997: Found a 5" Square Concrete Monument, 5' in length with a 3" Stamped Brass Disc, 1.5' below the ground.

Condition of the Witnesses are as follows:

Pit East 10 lks (1) GONE
 5" White Oak N-55°-E 99.05' (2) (6) FOUND
 7" White Oak N-20°-W 59.60' (3) (7) FOUND
 6" Black Oak N-03°-W 90.13' (4) (8) FOUND
 Pine Post North 33.02' (5) (9) FOUND


Corner B-13 ratified by the Manistee County Peer Group
 according to the county plan adopted pursuant to P.A. 345 of 1990,
 as amended, (being the State Survey and Remonument Act, MCL 54.261
 et. seq.). Date of Peer Review JUN 3 1997

C. Description of monument for corner and accessories established to perpetuate locating the position of the corner:

B-13 SOUTH QUARTER CORNER OF SECTION 31, T21N-R15W
 April 1997: Accepted the 5" Square Concrete Monument, 5' in length with a 3" Stamped Brass Disc, as a careful and faithful re-establishment of the position of the Original Corner.

7" White Oak N-55°-E 99.05' (2) (6)
 9" White Oak N-20°-W 59.60' (3) (7)
 9" Black Oak N-03°-W 90.13' (4) (8)
 9" Jack Pine S-22°-E 44.50'

This Corner is 9' North of the Centerline of the East-West Road.

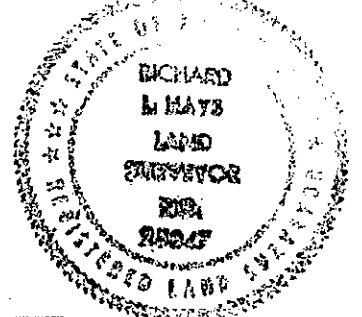

Signed by Richard Hays
 Surveyor's Michigan License No. 25847

Date 5/28/97