

SECTION

LAND CORNER RECORDATION CERTIFICATE
Filing Requirement of Act 74, Mich. P.A. 1970

Table with columns: For corners in Manistee (County), Located In: (Town/Range/Section), Corner Code #. Includes entries for Public Land Survey, Property Controlling in Section, and Miscellaneous Property in Section.

REGISTER'S OFFICE
MANISTEE COUNTY
76-182 at 1:00 pm
MAY 15 1996
Reborah Six
REGISTER OF DEEDS

Register of Deeds Stamp & File Number

4. Lot No. , Recorded Plat
5. Private Claims

Grid table with columns A-L and rows 2-13. A dot is marked at row 7, column C.

I, Richard Hays, in a field survey on April, 1996, do hereby certify that under requirements of P.A. 74, Michigan P.A. of 1970, the corner points mentioned in lines 1 and 2 above were in conformance with regulations and rules therefore as required in the current manual of survey instructions of the United States Department of the Interior, Bureau of Land Management or by a decree of a Court of Law and/or that the corner points mentioned in lines 3, 4 and 5 above were in conformance with the rules of the Michigan Board of Professional Surveyors or by a Decree of a Court of Law; established, re-established, monumented, re-monumented, recovered, found as expressed below:

NOTE: Not more than 4 corners, all in the same town and range, may be recorded on this certificate.

A. Description of original monument and accessories and/or subsequent restoration:

C-7 SECTION CORNER FOR SECTIONS 17, 18, 19 & 20
1837:G.L.O. Set Post
16" Y. Pine S-70 1/2-E 23 Lks(1)
22" W. Pine N-64-E 103 Lks(2)
1908:D. Skeels Book B, Pg 244
18" W. Oak N-23-W 43 Lks(3)
24" Y. Pine S-12-W 79 Lks(4)
1978:Robert Griffin #13584, L.C.R.C.
79-30:Found no evidence of Corner.
Placed a Conc. Mon. at computed location
7" B. Oak N-44-W 126.54'(5)
3" Jackpine S-76-E 9.91'(6)
9" B. Oak S-56-W 113.86'(7)
1979:Anthony Slawinski #13597, Act 74
Liber 1, Page 582

B. Description of corner evidence found and/or method applied in restoring or reestablishing corner:

C-7 SECTION CORNER FOR SECTIONS 17, 18, 19 & 20
1996:Found the Robert Griffin Concrete Monument. Condition of Recorded Witnesses are:

16" Y. Pine S-70 1/2-E 23 Lks(1) GONE
22" W. Pine N-64-E 103 Lks(2) GONE
18" W. Oak N-23-W 43 Lks(3) GONE
24" Y. Pine S-12-W 79 Lks(4) GONE
7" B. Oak N-44-W 126.54'(5) GOOD
3" Jackpine S-76-E 9.91'(6) GOOD
9" B. Oak S-56-W 113.86'(7) GOOD


Witnessed by the Manistee County Peer Group according to the county plan adopted pursuant to P.A. 345 of 1990 as amended, (being the State Survey and Reorganization Act, MCL 54.2F et. seq.) - Date of Peer Review MAY 07 1996
Anthony M. Slawinski

C. Description of monument for corner and accessories established to perpetuate locating the position of the corner:

C-7 SECTION CORNER FOR SECTIONS 17, 18, 19 & 20
1996:Accepted U.S.F.S. Monument with cap stamped to identify Corner, as a careful and faithful re-establishment of the position of the Original Corner
8" Jackpine S-76-E 9.00'(6) 9" B. Oak S-56-W 113.86'(7)
7" W. Pine N-12-W 10.77' Steinberg Rd North 112'
6" Jackpine S-44-E 29.78' Marzinski Rd East 55'
10" B. Oak N-44-W 126.54'(5)

Signed by Richard Hays

Surveyor's Michigan License No. 25847

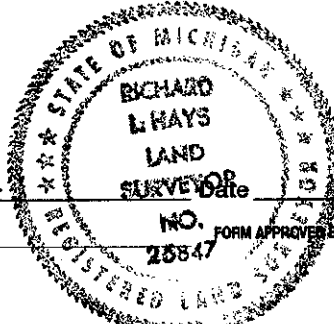

May 7 1996