

MAY 16 1997

COMMISSION

LAND CORNER RECORDATION CERTIFICATE
Filing Requirement of Act 74, Mich. P.A. 1970

For corners in Manistee (County) Located In: Corner Code #
1. Public Land Survey T 21N R 15W C-11
2. Property Controlling in Section S T R
3. Miscellaneous Property in Section S T R
4. Lot No. Recorded Plat
5. Private Claims

REGISTER'S OFFICE MANISTEE COUNTY

96-185 at 1:15pm MAY 15 1996

Deborah Six REGISTER OF DEEDS

Register of Deeds Stamp & File Number

Grid table with columns A-L and rows 1-13. A dot is marked at row 11, column B.

I, Richard Hays, in a field survey on April, 1996, do hereby certify that under requirements of P.A. 74, Michigan P.A. of 1970, the corner points mentioned in lines 1 and 2 above were in conformance with regulations and rules therefore as required in the current manual of survey instructions of the United States Department of the Interior, Bureau of Land Management or by a decree of a Court of Law and/or that the corner points mentioned in lines 3, 4 and 5 above were in conformance with the rules of the Michigan Board of Professional Surveyors or by a Decree of a Court of Law; established, re-established, monumented, re-monumented, recovered, found as expressed below:

NOTE: Not more than 4 corners, all in the same town and range, may be recorded on this certificate.

A. Description of original monument and accessories and/or subsequent restoration:

- C-11 SECTION CORNER COMMON TO SECTIONS 29, 30, 31 & 32
1837:G.L.O. Set Post 1949: Sam Walker, Set Conc. Monument
7" Maple S-80°-E 14 Lks(1)
7" W. Oak S-77°-W 36 Lks(2)
1975:Roser #12028 L.C.R.C. 77-11 Fd. Mon
7" W. Oak S-35°-E 6.8'(3)
9" W. Oak N-55°-E 33.1'(4)
4" R. Pine S-38°-W 5.3'(5)
Axle Shaft S-70°-13'-W 179.56'(6)
1976:Slawinski #13597 Act 132
L.1, Pg 351, Found Monument
5" R. Pine N-60°-W 31.91'(7)
4" R. Pine S-40°-W 24.02'(8)
6" W. Oak N-20°-W 27.91'(9)
7" W. Cherry S-75°-E 44.00'(10)

B. Description of corner evidence found and/or method applied in restoring or reestablishing corner:

C-11 SECTION CORNER COMMON TO SECTIONS 29, 30, 31 & 32
1996:Found and accepted Concrete Monument set by Sam Walker.

Condition of Recorded Witnesses are


Table listing witnesses: 7" Maple S-80°-E 14 Lks(1) GONE, 7" W. Oak S-77°-W 36 Lks(2) GONE, 7" W. Oak S-35°-E 6.8'(3) GOOD, 9" W. Oak N-55°-E 33.1'(4) GOOD, 4" R. Pine S-38°-W 5.3'(5) GOOD, Axle Shaft S-70°-13'-W 179.56'(6) DID NOT LOCATE, 5" R. Pine N-60°-W 31.91'(7) GOOD, 4" R. Pine S-40°-W 24.02'(8) GOOD, 6" W. Oak N-20°-W 27.91'(9) GONE, 7" W. Cherry S-75°-E 44.00'(10) GOOD

C. Description of monument for corner and accessories established to perpetuate locating the position of the corner:

C-11 SECTION CORNER COMMON TO SECTIONS 29, 30, 31 & 32
1996:Accepted Concrete Monument with Steel Rod for Corner and is accepted as the best available evidence of the position of the Original Corner.
14" W. Oak N-52°-E 33.60' Post Northwest 1.5'
12" W. Oak S-84°-W 20.46' Corner is 100' South of two-track and Power Line
13" W. Oak S-42°-E 7.22'
6" R. Pine S-38°-W 5.61'

ratified by the Manistee County Peer Group according to the county plan accepted pursuant to P.A. 345 of 1990, as amended, (being the State Survey and Monument Act, MCL 54.261 et. seq.). Date of Peer-Review: MAY 15 1996
Anthony M. Slawinski

Signed by Richard Hays
Surveyor's Michigan License No. 25847

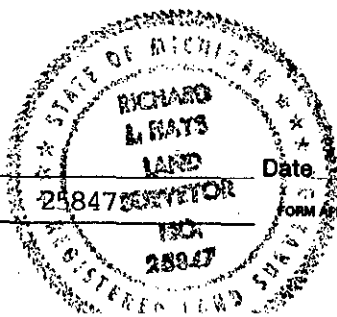

Date May 7 1996