

LAND CORNER RECORDATION CERTIFICATE
Filing Requirement of Act 74, Mich. P.A. 1970

For corners in <u>Manistee</u> <small>(County)</small>	Located In:	Corner Code #
1. Public Land Survey	T <u>21N</u> R <u>15W</u>	<u>C-13</u>
	T _____ R _____	_____
	T _____ R _____	_____
	T _____ R _____	_____
2. Property Controlling in Section	S _____ T _____ R _____	_____
	S _____ T _____ R _____	_____
3. Miscellaneous Property in Section	S _____ T _____ R _____	_____
	S _____ T _____ R _____	_____

REGISTER'S OFFICE
MANISTEE COUNTY
96-180 ut 11:55 AM
MAY 15 1996
Deborah Six
REGISTER OF DEEDS

Register of Deeds Stamp & File Number

4. Lot No. _____, Recorded Plat _____
 5. Private Claims _____

A	B	C	D	E	F	G	H	I	J	K	L	M
2	6	5	4	3	2	1						
3												
4	7	8	9	10	11	12						
5												
6	18	17	16	15	14	13						
7												
8	19	20	21	22	23	24						
9												
10	30	29	28	27	26	25						
11												
12	31	32	33	34	35	36						
13												

I, Richard L. Hays, in a field survey on April, 1996, do hereby certify that under requirements of P.A. 74, Michigan P.A. of 1970, the corner points mentioned in lines 1 and 2 above were in conformance with regulations and rules therefore as required in the current manual of survey instructions of the United States Department of the Interior, Bureau of Land Management or by a decree of a Court of Law and/or that the corner points mentioned in lines 3, 4 and 5 above were in conformance with the rules of the Michigan Board of Professional Surveyors or by a Decree of a Court of Law; established, re-established, monumented, re-monumented, recovered, found as expressed below:

NOTE: Not more than 4 corners, all in the same town and range, may be recorded on this certificate.

A. Description of original monument and accessories and/or subsequent restoration:
C-13 SECTION CORNER COMMON TO SECTIONS 31 & 32

1837:G.L.O. Set Post	1971:Griffin #13584 l.c.r.c. 72-22	1975:Roser #12028 L.C.R.C. 77-14
12" Y. Pine N-06°-E 587 LKS(1)	Did not recover Corner. Set Corner from Witness #2.	Section Survey, Pound U.S.F.S. Mon.
	3" W. Oak	N-29°-E 77.73'(9)
1918:Theodore Norlin	3" W. Oak	N-29°-E 77.73'(4)
15" W. Oak N-20°-W 100.2'(2)	2"x36" Iron Pipe	N-65°-E 77.66'(5)
12" B. Oak N-42°-E 103.3'(3)	1-1/4" Pipe	N-66°-W 34.94'(11)
	1-1/4" Pipe	N-66°-W 34.94'(6)
	3" W. Oak	N-04°-W 60.58'(7)
	4"x7" Post	North 32.97'(8)

B. Description of corner evidence found and/or method applied in restoring or reestablishing corner:
C-13 SECTION CORNER COMMON TO SECTIONS 31 & 32

1996: Found U.S.F.S. Monument in Road. Condition of Recorded Witnesses are

12" Y. Pine	N-06°-E	587 LKS(1)	GONE
15" W. Oak	N-20°-W	100.2'(2)	GOOD
12" B. Oak	N-42°-E	103.3'(3)	GONE
3" W. Oak	N-29°-E	77.73'(4)(9)	GOOD
2"x36" Iron Pipe	N-65°-E	77.66'(5)(10)	Did NOT LOCATE
1-1/4" Pipe	N-66°-W	34.94'(6)(11)	Good
3" W. Oak	N-04°-W	60.58'(7)(12)	GOOD
4"x7" Post	North	32.97'(8)	GONE

Corner C-13 certified by the Manistee County Peer Group according to the county plan adopted pursuant to P.A. 345 of 1990, as amended, (being the State Survey and Reorganization Act, MCL 54.261 et. seq.). Date of Peer Review: May 10 1996


Anthony M. Slawinski

C. Description of monument for corner and accessories established to perpetuate locating the position of the corner:
C-13 SECTION CORNER COMMON TO SECTIONS 31 & 32

1996: Accepted U.S.F.S. Monument with brass cap stamped to identify Corner and is accepted as a careful and faithful reestablishment of the Original Corner.

9" W. Oak	N-04°-W	60.56'(7)
7" W. Oak	N-30°-E	77.70'(4)
15" W. Oak	S-45°-W	53.80'
12" B. Oak	S-36°-E	58.77'
Centerline of Road	North	3.00'

Signed by: Richard Hays
 Surveyor's Michigan License No. 25847

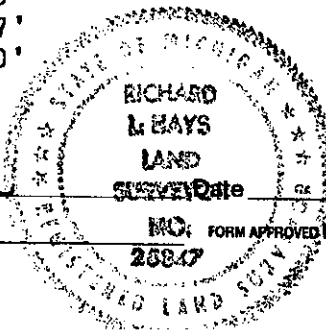

Date: May 7 1996