

MAY 18 1997

LAND CORNER RECORDATION CERTIFICATE
Filing Requirement of Act 74, Mich. P.A. 1970

For corners in Manistee (County)

Located In:

Corner Code #

- 1. Public Land Survey T 21N R 15W E-13
2. Property Controlling in Section S T R
3. Miscellaneous Property in Section S T R

REGISTER'S OFFICE MANISTEE COUNTY

96-178 at 11:45 AM MAY 15 1996

Deborah Six

REGISTER OF DEEDS

Register of Deeds Stamp & File Number

- 4. Lot No. , Recorded Plat
5. Private Claims

Grid table with columns A-L and rows 2-13. A dot is present at row 12, column C.

Richard L. Hays April 96

I, Richard L. Hays, in a field survey on April 19 96, do hereby certify that under requirements of P.A. 74, Michigan P.A. of 1970, the corner points mentioned in lines 1 and 2 above were in conformance with regulations and rules therefore as required in the current manual of survey instructions of the United States Department of the Interior, Bureau of Land Management or by a decree of a Court of Law and/or that the corner points mentioned in lines 3, 4 and 5 above were in conformance with the rules of the Michigan Board of Professional Surveyors or by a Decree of a Court of Law; established, re-established, monumented, re-monumented, recovered, found as expressed below:

NOTE: Not more than 4 corners, all in the same town and range, may be recorded on this certificate.

A. Description of original monument and accessories and/or subsequent restoration:

- E-13 SECTION CORNER COMMON TO SECTIONS 32 & 33
1837:G.L.O. Set Post 1918:Theodore Norlin 1971:Griffin #13584 L.C.R.C. 72-24
10" W. Oak N-80-1/2-E 155 Lks(1) 15" W. Oak N-60-E 19.60'(5) Did not recover Corner. Re-established
16" W. Pine S-85-1/2-E 192 Lks(2) Conc. Mon East 231.00'(6) Corner.
7" W. Oak N-23-E 72.34'(7)
1908:E.H. Baird, Mon "Pd. Old Corner 1975:Roser #12028 L.C.R.C. 77-12 7" W. Oak N-57-W 96.70'(8)
6" Poplar N-69-W 52 Lks(3) Found U.S.F.S. Monument 2" W. Pine N-02-W 38.20'(9)
18" W. Pine Stmp N-83-E 36 Lks(4) Found Witnesses #6-#10 4"x7' Post North 35.98'(10)

B. Description of corner evidence found and/or method applied in restoring or reestablishing corner:

E-13 SECTION CORNER COMMON TO SECTIONS 32 & 33
1996:Found U.S.G.S. Monument in Road Condition of Recorded Witnesses are

- 10" W. Oak N-80-1/2-E 155 Lks(1) GONE
16" W. Pine S-85-1/2-E 192 Lks(2) GONE
6" Poplar N-69-W 52 Lks(3) GONE
18" W. Pine Stmp N-83-E 36 Lks(4) GONE
15" W. Oak N-60-E 19.60'(5) GONE
Conc. Monument East 231.00'(6) GOOD
7" W. Oak N-23-E 72.34'(7) GOOD
7" W. Oak N-57-W 96.70'(8) GOOD
2" W. Pine N-02-W 38.20'(9) GONE
4"x7' Post North 35.98'(10)GONE

Corner E-13 ratified by the Manistee County Peer Group according to the county plan adopted pursuant to P.A. 345 of 1990, as amended, (being the State Survey and Remonument Act, MCL 54.261 et. seq.). Date of Peer Review: MAY 07 1996

Anthony M. Slawinski


C. Description of monument for corner and accessories established to perpetuate locating the position of the corner:

E-13 SECTION CORNER COMMON TO SECTIONS 32 & 33
1996:Accepted U.S.F.S. Monument with Brass Cap stamped to identify Corner and is accepted as a careful and faithful re-establishment of the position of the Original Corner.

- 12" W. Oak N-23-E 72.34'(7) Conc. Mon(NE Cor Sec. 6) East 231.00'
12" B. Oak N-57-W 96.70'(8) Centerline of Road North 4.00'
12" B. Oak S-40-W 42.36'
11" B. Oak S-34-E 40.05'

Signed by Richard Hays

Surveyor's Michigan License No. 25847

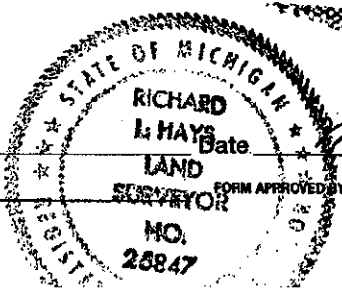

May 7 1996