

REMOVAL

MAY 1 1996

LAND CORNER RECORDATION CERTIFICATE
Filing Requirement of Act 74, Mich. P.A. 1970

For corners in Manistee (County) Located In: Corner Code #
1. Public Land Survey T 21N R 15W F-13
2. Property Controlling in Section S T R
3. Miscellaneous Property in Section S T R

REGISTER'S OFFICE MANISTEE COUNTY
96-176 at 11:35 AM
MAY 15 1996
Deborah Six
REGISTER OF DEEDS

Register of Deeds Stamp & File Number

4. Lot No. , Recorded Plat
5. Private Claims

Grid table with columns A-M and rows 1-13. A dot is marked at row 10, column G.

Richard L. Hays, in a field survey on April, 1996, do hereby certify that under requirements of P.A. 74, Michigan P.A. of 1970, the corner points mentioned in lines 1 and 2 above were in conformance with regulations and rules therefore as required in the current manual of survey instructions of the United States Department of the Interior, Bureau of Land Management or by a decree of a Court of Law and/or that the corner points mentioned in lines 3, 4 and 5 above were in conformance with the rules of the Michigan Board of Professional Surveyors or by a Decree of a Court of Law; established, re-established, monumented, re-monumented, recovered, found as expressed below:

NOTE: Not more than 4 corners, all in the same town and range, may be recorded on this certificate.

A. Description of original monument and accessories and/or subsequent restoration:

F-13 SOUTH QUARTER CORNER FOR SECTION 33
1837:G.L.O. Survey 1975:Roser #12028 L.C.R.C. 77-08
16" W. Pine N-28°-E 56 Lks(1) Section Survey, Found Well Point
14" W. Pine N-81 1/2°-W 30 Lks(2) used by Clint Cole
8" W. Oak N-25°-W 7.54'(3)
5" W. Pine N-55°-E 31.26'(4)
N 1/4 Sec. 5 T20N-R15W S-87°-34'-E 164.5' (5)

B. Description of corner evidence found and/or method applied in restoring or reestablishing corner:

F-13 SOUTH QUARTER CORNER FOR SECTION 33
1996:Found 1/2" Re-Rod with Ross Cap.
Condition of Recorded Witnesses are:
16" W. Pine N-28°-E 56 Lks(1) GONE
14" W. Pine N-81 1/2°-W 30 Lks(2) GONE
8" W. Oak N-25°-W 7.54'(3) GOOD
5" W. Pine N-55°-E 31.26'(4) GOOD
N1/4 Sec. 5 T20N-R15W S-87°-34'-E 164.5' (5) GOOD


retified by the Manistee County Peer Group according to the county plan adopted pursuant to P.A. 345 of 1990, as amended, (being the State Survey and Remonument Act, MCL 54.261 et. seq.) Date of Peer Review: MAY 17 1996

Anthony M. Dawinski

C. Description of monument for corner and accessories established to perpetuate locating the position of the corner:

F-13 SOUTH QUARTER CORNER FOR SECTION 33
1996:Replaced Ross Iron. Under Ross Iron was a Well Point and placed a MANISTEE COUNTY MONUMENT over the Well Point and stamped Monument to identify Corner, and is accepted as a careful and faithful reestablishment of the position of the Original Corner.
12" W. Oak N-25°-W 7.54'(3) 14" W. Oak N-72°-W 24.46'
9" W. Oak S-08°-E 29.10' 8" W. Pine N-52°-E 31.36'(4)
20" W. Oak S-80°-E 32.17' West 1.7'
N-1/4 Corner Section 5 T20N-R15W East 0184.05' (5)
& Trail Road South 8 feet

Signed by Richard Hays
Surveyor's Michigan License No. 25847

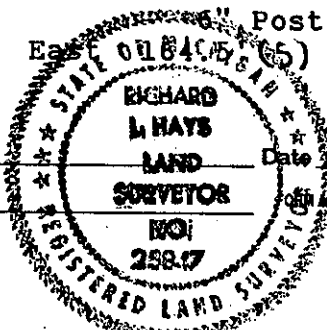

Date May 7 1996