

SURVEY
REMONUMENT
MAY 15 1996

LAND CORNER RECORDATION CERTIFICATE
Filing Requirement of Act 74, Mich. P.A. 1970

For corners in Manistee (County) Located In: _____ Corner Code # _____

1. Public Land Survey	T	21N	R	15W	G-13
	T		R		
	T		R		
	T		R		
2. Property Controlling in Section	S	T	R		
	S	T	R		
3. Miscellaneous Property in Section	S	T	R		
	S	T	R		

4. Lot No. _____, Recorded Plat _____
5. Private Claims _____

REGISTER'S OFFICE
MANISTEE COUNTY
96-177at 11:40 AM
MAY 15 1996
Debrah Six
REGISTER OF DEEDS

Register of Deeds Stamp & File Number

A	B	C	D	E	F	G	H	I	J	K	L	A
2	6	5	4	3	2	1						
3												
4	7	8	9	10	11	12						
5												
6	18	17	16	15	14	13						
7												
8	19	20	21	22	23	24						
9												
10	30	29	28	27	26	25						
11												
12	31	32	33	34	35	36						
13												

I, Richard Hays, in a field survey on April, 19 96, do hereby certify that under requirements of P.A. 74, Michigan P.A. of 1970, the corner points mentioned in lines 1 and 2 above were in conformance with regulations and rules therefore as required in the current manual of survey instructions of the United States Department of the Interior, Bureau of Land Management or by a decree of a Court of Law and/or that the corner points mentioned in lines 3, 4 and 5 above were in conformance with the rules of the Michigan Board of Professional Surveyors or by a Decree of a Court of Law; established, re-established, monumented, re-monumented, recovered, found as expressed below:

NOTE: Not more than 4 corners, all in the same town and range, may be recorded on this certificate.

A. Description of original monument and accessories and/or subsequent restoration:

G-13 SECTION CORNER COMMON TO SECTIONS 33 & 34
1837:G.L.O. Set Post 1977:Griffin #13584 L.C.R.C. 77-34, 78-4. Found no Evidence of Corner. Set U.S.F.S. Monument on a straight line and at a proportional distance between controlling standard corners.
10" W. Pine N-80°-E 7 Lks(1)
10" W. Pine N-86°-W 57 Lks(2)
1976:Roser #12028 L.C.R.C. 77-18 NE Cor. Sec 4(T20N-R15W) East 115.60'(3)
Section Survey Pd. U.S.G.S. Mon. 3" R. Oak N-76°-W 44.34'(4)
Found Witnesses #3-#5 5" W. Oak N-27°-W 27.23'(5)
4"x7' Post North 1.50'(6)

B. Description of corner evidence found and/or method applied in restoring or reestablishing corner:

G-13 SECTION CORNER COMMON TO SECTIONS 33 & 34
1996:Found U.S.F.S. Monument set by Robert Griffin. Condition of Recorded Witnesses are

10" W. Pine N-80°-E 7 Lks(1)GONE
10" W. Pine N-86°-W 57 Lks(2)GONE
NE Cor. Sec 4(T20N-R15W) East 115.60'(3)GOOD
3" R. Oak N-76°-W 44.34'(4)GOOD
5" W. Oak N-27°-W 27.23'(5)GOOD
4"x7' Post North 1.50'(6)GOOD


Corner G-13 ratified by the Manistee County Peer Group according to the county plan adopted pursuant to P.A. 345 of 1990, as amended, (being the State Survey and Remonument Act, MCL 54.261 et. seq.). Date of Peer Review: MAY 07 1996

Anthony M. Slawinski

C. Description of monument for corner and accessories established to perpetuate locating the position of the corner:

G-13 SECTION CORNER COMMON TO SECTIONS 33 & 34
1996:Accepted 5" Concrete Monument with Brass Cap stamped to identify Corner and is accepted as a the best available evidence of the position of the Original Corner.

12" W. Oak N-25°-W 27.23'(5)
10" R. Oak S-76°-E 44.34'(4)
12" W. Pine S-58°-E 61.05'
12" B. Oak S-52°-W 78.75'
4"x7' Post North 1.5'
NE Cor. Sec. 4(T20N-R15W) East 115.84'(3)
Centerline Two-Track Trail West 12.00'

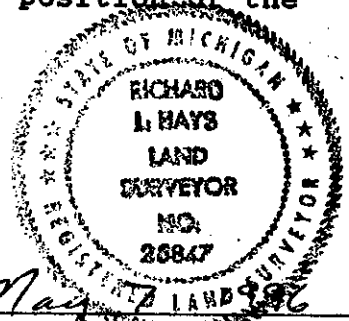

Signed by Richard Hays Date May 15 1996

Surveyor's Michigan License No. 25847