

SUB
REMONUMENT
OCT 3 1994

LAND CORNER RECORDATION CERTIFICATE
Filing Requirement of Act 74, Mich. P.A. 1970

For corners in

Manistee
(County)

Located In: _____ Corner Code # _____

1. Public Land Survey T 21N R 15W H - 3
T _____ R _____
T _____ R _____
T _____ R _____

2. Property Controlling S _____ T _____ R _____
In Section S _____ T _____ R _____

3. Miscellaneous S _____ T _____ R _____
Property in Sec. S _____ T _____ R _____

4. Lot No. _____, Recorded Plat _____

5. Private Claims _____

REGISTER'S OFFICE
MANISTEE COUNTY
#94-373 AT 2:55 p.m.
AUG 16 1994
Penny A. Raw
REGISTER OF DEEDS

Register of Deeds Stamp & File Number

I, Kenneth L. Ross, in a field survey on July 1994, do hereby certify that under requirements of P.A. 74, Michigan P.A. of 1970, the corner points mentioned in lines 1 and 2 above were in conformance with regulations and rules therefore as required in the current manual of survey instructions of the United States Department of the Interior, Bureau of Land Management or by a decree of a Court of Law and/or that the corner points mentioned in lines 3, 4 and 5 above were in conformance with the rules of the Michigan Board of Land Surveyors or by a Decree of a Court of Law, established, re-established, monumented, re-monumented, recovered, found as expressed below:

	A	B	C	D	E	F	G	H	I	J	K	L	M
2	6	5	4	3	2	1							
3													
4	7	8	9	10	11	12							
5													
6	18	17	16	15	14	13							
7													
8	19	20	21	22	23	24							
9													
10	30	29	28	27	26	25							
11													
12	31	32	33	34	35	36							
13													

NOTE: Not more than 4 corners, all in the same town and range, may be recorded on this certificate.

A. Description of original monument and accessories and/or subsequent restoration:

H-3 One-quarter corner common to sections 3 & 10 T21N, R15W
1837 John Brink D.S., G.L.O. set wood post page 41
1. Beech 9" S10W 32 lks
2. Beech 9" N02W 20 lks

July 23 1907 E.W. Muenschler honored fence post as corner location Book A pages 39 & 40
3. W. Oak 8" s193/4W 111 lks
4. W. Oak 7" S75½E 73 lks

1992 Ken Ross set 1/2" rebar with cap in place of found spike.
5. Powerpole N09W 37.65 ft.
6. Post S07W 32.10 ft.
7 White Oak 8" S62W 38.69 ft.


B. Description of corner evidence found and/or method applied in restoring or reestablishing corner:

H-3 One-quarter corner common to sections 3 & 10 T21N, R15W
On 7/21/94, found ½" re-bar with P.S. cap just below road surface in centerline of Pine Creek Road, condition of record witnesses,
1. gone 2. gone 3. gone 4. gone 5. found in good condition
6. found in good condition 7. found in good condition

Corner H-03 ratified by the Manistee County Peer Group according to the county plan adopted pursuant to P.A. 345 of 1990, as amended, (being the State Survey and Remonument Act, MCL 54.261 et seq.). Date of Peer Review: Bruce J. Jensen
acting CHAIRMAN APPROVED AUG 1 1994

C. Description of monument for corner and accessories established to perpetuate locating the position of the corner:

H-3 One-quarter corner common to sections 3 & 10 T21N, R15W
Replaced ½" re-bar with a Manistee County Monument (2½" x 30" steel pipe with a brass cap) and is accepted as a careful and faithful reestablishment of the original corner.
(OBT 5) Powerpole N09W 37.65 ft (16d nail with shiner on East side of pole)
(OBT 7) White Oak 7" S55W 38.69 ft (60d nail on NW side)
Black Oak 12" S60E 96.48 ft. (60d nail on SW side)
White Oak 12" S08E 65.93 ft. (60d nail in NE side)

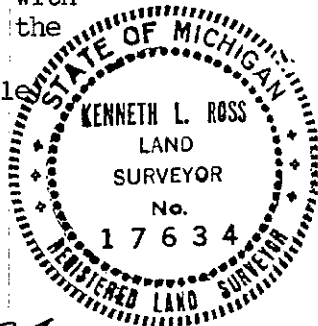

Signed by Kenneth L. Ross
Surveyor's Michigan License No. 17634

Date Aug. 1, 1994