

**LAND CORNER RECORDATION CERTIFICATE**  
**Filing Requirement of Act 74, Mich. P.A. 1970**

For corners in Manistee (County) Located In: \_\_\_\_\_ Corner Code # \_\_\_\_\_

1. Public Land Survey	T <u>21</u> N	R <u>15</u> W	<u>H-13</u>
	T _____	R _____	_____
	T _____	R _____	_____
	T _____	R _____	_____
2. Property Controlling in Section	S _____	T _____	R _____
	S _____	T _____	R _____
3. Miscellaneous Property in Section	S _____	T _____	R _____
	S _____	T _____	R _____

**REGISTER'S OFFICE**  
**MANISTEE COUNTY**  
*96-175 at 11:30 AM*  
**MAY 15 1996**  
*Deborah Sue*  
**REGISTER OF DEEDS**

Register of Deeds Stamp & File Number

4. Lot No. \_\_\_\_\_, Recorded Plat \_\_\_\_\_  
 5. Private Claims \_\_\_\_\_

A	B	C	D	E	F	G	H	I	J	K	L
2	6	5	4	3	2	1					
3											
4	7	8	9	10	11	12					
5											
6	18	17	16	15	14	13					
7											
8	19	20	21	22	23	24					
9											
10	30	29	28	27	26	25					
11											
12	31	32	33	34	35	36					
13											

I, Richard L. Hays, in a field survey on April, 1996, do hereby certify that under requirements of P.A. 74, Michigan P.A. of 1970, the corner points mentioned in lines 1 and 2 above were in conformance with regulations and rules therefore as required in the current manual of survey instructions of the United States Department of the Interior, Bureau of Land Management or by a decree of a Court of Law and/or that the corner points mentioned in lines 3, 4 and 5 above were in conformance with the rules of the Michigan Board of Professional Surveyors or by a Decree of a Court of Law; established, re-established, monumented, re-monumented, recovered, found as expressed below:

**NOTE: Not more than 4 corners, all in the same town and range, may be recorded on this certificate.**

**A. Description of original monument and accessories and/or subsequent restoration:**

**H-13 SOUTH QUARTER CORNER FOR SECTION 34**  
 1837:G.L.O. Survey Set 1956:Dotd Survey 1972:Griffin #13584 L.C.R.C. 73-37  
 10" Cedar for Corner N1/4 Cor. Section 4 Fd. Dotd Iron, Set U.S.F.S. Mon.  
 T20N-R15W S-89°-E 143.6'(1) Witnesses #1 & #2 GOOD  
 1977:Roser #12028 Iron Pipe on Section 7" Ash N-88°-E 63.19'(3)  
 L.C.R.C. 77-18 Line S-89°-07'-E 511.5'(2) 1 1/2" Iron Pipe North 23.56' River Bank(4)  
 Section Survey Post North 1.3'(5)  
 Found U.S.F.S. Monument  
 South Edge L.M.R. North 24.00'(6)

**B. Description of corner evidence found and/or method applied in restoring or reestablishing corner:**

**H-13 SOUTH QUARTER CORNER FOR SECTION 34**  
 1996:Found U.S.F.S. Monument set by Griffin.  
 Condition of the Recorded Witnesses are as follows:

N1/4 Cor. Section 4	T20N-R15W	S-89°-E	143.6'(1)GOOD
Iron Pipe on Section Line		S-89°-07'-E	511.5'(2)DID NOT CHECK
	7" Ash	N-88°-E	63.19'(3)GOOD
	1 1/2" Iron Pipe	North	23.56' River Bank(4)GONE
	Post	North	1.3'(5)GOOD
	South Edge L.M.R.	North	24.00'(6)GONE

Corner **H-13** ratified by the Manistee County Peer Group according to the county plan adopted pursuant to P.A. 345 of 1990, as amended, (being the State Survey and Remuneration Act, MCL 54.261 et seq.) - Date of Peer Review: \_\_\_\_\_


*Anthony M. Shamber*

**C. Description of monument for corner and accessories established to perpetuate locating the position of the corner:**

**H-13 SOUTH QUARTER CORNER FOR SECTION 34**  
 1996:Accepted 5' Square Concrete Monument with Brass Cap stamped to identify the Corner and is accepted as the best available evidence of the position of the Original Corner.

N1/4 Cor. Section 4	T20N-R15W	S-89°-E	143.6'(1)
	7" Ash	N-88°-E	63.19'(3)GOOD
	20" Maple	S-26°-E	39.65'
	28" Hemlock	S-58°-W	68.44'
	Post	North	1.3'(5)
	South Edge L.M.R.	North	24.00'(6)

Signed by Richard Hays  
 Surveyor's Michigan License No. 25847

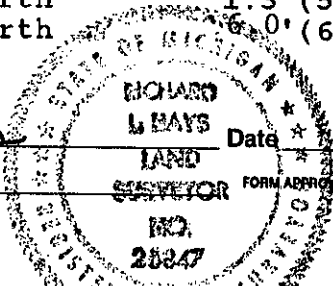

Date May 7 1996