

LAND CORNER RECORDATION CERTIFICATE
Filing Requirement of Act 74, Mich. P.A. 1970

For corners in

Manistee
(County)

Located In:

Corner Code #

- | | | | | | |
|------------------------------------|---|------------|---|------------|--------------|
| 1. Public Land Survey | T | <u>21N</u> | R | <u>15W</u> | <u>I - 3</u> |
| | T | | R | | |
| | T | | R | | |
| | T | | R | | |
| 2. Property Controlling in Section | S | | T | | R |
| | S | | T | | R |
| 3. Miscellaneous Property in Sec. | S | | T | | R |
| | S | | T | | R |
4. Lot No. _____, Recorded Plat _____
 5. Private Claims _____

REGISTER'S OFFICE
 MANISTEE COUNTY

95-212 at 1:30pm

JUN 7 1995

Deborah Six Dep
 REGISTER OF DEEDS

Register of Deeds Stamp & File Number

I, Sammy S. Barnett in a field survey on May 25, 19 95, do hereby certify that under requirements of P.A. 74, Michigan P.A. of 1970, the corner points mentioned in lines 1 and 2 above were in conformance with regulations and rules therefore as required in the current manual of survey instructions of the United States Department of the Interior, Bureau of Land Management or by a decree of a Court of Law and/or that the corner points mentioned in lines 3, 4 and 5 above were in conformance with the rules of the Michigan Board of Land Surveyors or by a Decree of a Court of Law; established, re-established, monumented, re-monumented, recovered, found as expressed below:

NOTE: Not more than 4 corners, all in the same town and range, may be recorded on this certificate.

A	B	C	D	E	F	G	H	I	J	K	L	M
2	6	5	4	3	2	1						
3												
4	7	8	9	10	11	12						
5												
6	18	17	16	15	14	13						
7												
8	19	20	21	22	23	24						
9												
10	30	29	28	27	26	25						
11												
12	31	32	33	34	35	36						
13												

A. Description of original monument and accessories and/or subsequent restoration:

- I-3 Section corner common to sections 2, 3, 10 & 11 T21N, R15W
 1837 John Brink D.S., GLO set wood post Page 38
 1. Y. Pine 14" N59E 37 lks
 2. W. Pine 14" S54W 56 lks
 23 May 1907 E.W. Muenscher set corner from what he thought were original bearing trees, book A Pages 39-40
 3. W. Pine stump 14" S65 $\frac{1}{4}$ E 24 lks
 4. W. Pine stump 18" S53W 57 lks
- 1970 R. Griffen USFS found $\frac{1}{2}$ " pipe 1 ft. below road surface in NE quadrant of road intersection
 5. Powerpole N75E 122.29 ft.
 6. Powerpole S46W 53.57 ft.
- Over

B. Description of corner evidence found and/or method applied in restoring or reestablishing corner:

- I-3 Section corner common to section 2,3,10 & 11 T21N, R15W
 On July 21, 1994, found $\frac{1}{2}$ " pipe 1 ft. below road surface in NE quadrant of road intersection.

Condition of record witnesses are; 1. gone 2. gone 3. gone 4. gone 5. found in good condition 6. gone 7. found in good condition 8. found in good condition 9 same as 10. found in good condition 11. found in good condition

C. Description of monument for corner and accessories established to perpetuate locating the position of the corner:

- I-3 Section corner common to sections 2, 3, 10 & 11, T21N, R15W

Replaced $\frac{1}{2}$ " iron with a Manistee County monument (2 $\frac{1}{2}$ " x 30" steel pipe with brass cap), and is accepted as a careful and faithful reestablishment of the position of the original corner.


- (OBT 5 & 9) Powerpole N77E 122.45 (added 60d nail in NW side)
 (OBT 7) Powerpole guy pole N45E 31.07 ft. (added 60d nail in NW side)
 (OBT 8) Red Oak 12" S45W 63.27 ft. (added 60d nail in NE side)
 (OBT 11) Red Oak 16" S54W 90.21 ft. (60d nail in NW side)

ratified by the Manistee County Peer Group according to the county plan adopted pursuant to P.A. 345 of 1990, as amended, (being the State Survey and Reimbursement Act, MCL 54.261 et. seq.) . Date of Review: JUN 6 1995

Patricia R. George

Signed by *Sammy S. Barnett*
 Surveyor's Michigan License No. 16923

Date 6-5-95

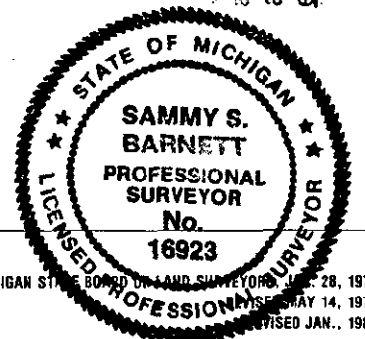

1974 T. Slawinski liber 1, page 225
found $\frac{1}{2}$ " pipe
7. Power guy pole N45E 31.08 ft.
8. R. Oak 10" S45E 63.27 ft.

1992 K. Ross
found $\frac{1}{2}$ " pipe
9. Powerpole N77E 122.45 ft.
10. W. Pine 10" S18E 57.5 ft.
11. W. Oak 12" S54W 90.21 ft.