

OCT 31 1994

COMMISSION

LAND CORNER RECORDATION CERTIFICATE  
Filing Requirement of Act 74, Mich. P.A. 1970

For corners in

Manistee  
(County)

Located In:

Corner Code #

- 1. Public Land Survey      T 21N R 15W
- T     R
- T     R
- T     R
- 2. Property Controlling    S     T     R
- in Section               S     T     R
- 3. Miscellaneous           S     T     R
- Property in Sec.         S     T     R

K - 4

\_\_\_\_\_

\_\_\_\_\_

\_\_\_\_\_

\_\_\_\_\_

REGISTER'S OFFICE  
MANISTEE COUNTY

#94-378 AT 4:25 p.m.

AUG 16 1994

*Bonny A. Peper*  
REGISTER OF DEEDS

Register of Deeds Stamp & File Number

- 4. Lot No. \_\_\_\_\_, Recorded Plat \_\_\_\_\_
- 5. Private Claims \_\_\_\_\_

	A	B	C	D	E	F	G	H	I	J	K	L	M
2	6	5	4	3	2	1							
3													
4	7	8	9	10	11	12							
5													
6	18	17	16	15	14	13							
7													
8	19	20	21	22	23	24							
9													
10	30	29	28	27	26	25							
11													
12	31	32	33	34	35	36							
13													

I, Kenneth L Ross in a field survey on July 19 94

do hereby certify that under requirements of P.A. 74, Michigan P.A. of 1970, the corner points mentioned in lines 1 and 2 above were in conformance with regulations and rules therefore as required in the current manual of survey instructions of the United States Department of the Interior, Bureau of Land Management or by a decree of a Court of Law and/or that the corner points mentioned in lines 3, 4 and 5 above were in conformance with the rules of the Michigan Board of Land Surveyors or by a Decree of a Court of Law; established, re-established, monumented, re-monumented, recovered, found as expressed below:

NOTE: Not more than 4 corners, all in the same town and range, may be recorded on this certificate.

A. Description of original monument and accessories and/or subsequent restoration:

K-4 One-quarter corner common to sections 11 & 12, T21N, R15W

~~1838~~ ~~1983~~ John Brink D.S., GLO set wood post page 35

- 1. W. Pine 18" N58W 28 lks
- 2. W. Pine 13" S38E 20 lks
- 1908 Don Skeels book B page 238
- 3. W. Pine stump S38E 20 lks
- 4. W. Pine Stump N58W 28 lks
- 1961 T.J. Vaillencourt, iron rod
- 5. Iron (on E & W 1/4 line) West 208.71 ft.

- 1967 Tony Slawinski found axel shaft
- 6. W. Oak 12" NE 30.58 ft.
- 7. W. Oak 12" SE 21.22 ft.
- 8. Twin W. Oak 6" SW 25.61 ft.
- 1970 R. Griffen found 3/4x41" iron rod replaced with 5"x36" concrete monument with brass cap (USFS monument)
- 9. W. Pine 3" N42E 46.39 ft. (see below)

B. Description of corner evidence found and/or method applied in restoring or reestablishing corner:

K-4 One-quarter corner common to sections 11 & 12, T21N, R15W

On July 26, 1994, found USFS concrete Monument with brass cap, and is accepted as a careful and faithful reestablishment of the position of the original corner. Condition of record witnesses are, 1 gone 2 gone 3 same as 2 4 same as 1, 5 found in good condition 6 found in good condition 7 gone 8 gone 9 found in good condition 10 found in good condition 11 found in good condition 12 found in good condition 13 found in good condition 14 same as 9, 15 found in good condition

- 10. 1 1/4" well pipe N46E 65.36 ft.
- 11. 4"x7" treated wood post East 32.97 ft.
- 12. NE cor. foundation S21W 85.73 ft.
- 13. B. Oak 7" N38W 93.79 ft.
- 1986 K. Ross same as R. Griffin
- 1990 T. Slawinski found USFS marker
- 14. Pine 8" N42E 46.46 ft.
- 15. Oak 12" S58E 52.06 ft.


C. Description of monument for corner and accessories established to perpetuate locating the position of the corner:

K-4 One-quarter corner common to sections 11 & 12, T21N, R15W

USFS concrete monument with brass cap is accepted as a substantial monument and is accepted as a careful and faithful reestablishment of the position of the original corner.

- (OBT 6) White Oak 15" N49E 30.50 ft. (added 60d nail in NW side)
- (OBT 9) White Pine 8" N42E 46.39 ft. (dock spike in SE side)
- (OBT 13) Black Oak 10" N38W 93.79 ft. (dock spike in SW side)
- (OBT 15) Black Oak 12" S58E 52.06 ft. (dock spike in SW side)

ratified by the Manistee County Peer Group according to the county plan adopted pursuant to P.A. 345 of 1990, as amended, (being the State Survey and Monument Act, MCL 54.261 et. seq.). Date of Peer Review: August 11, 1994  
APPROVED AUG 1 1994  
act. ch. chairman

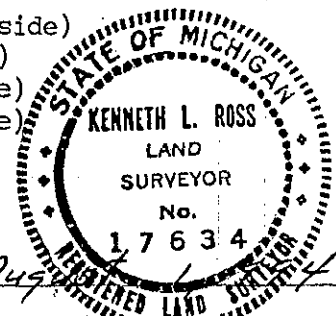

Signed by Kenneth L. Ross  
Surveyor's Michigan License No. 17634

Date Aug 16 1994