SURVEY & REMONUMENTATION

OCT 3 1 1994

COMMISSION

# LAND CORNER RECORDATION CERTIFICATE

**Filing Requirement of Act 74, Mich. P.A. 1970**

For corners in Manistee (County)

REGISTER'S OFFICE
MANISTEE COUNTY
#94-377 AT 3:47 p.m.
AUG 16 1994
Penny A. Rocca
REGISTER OF DEEDS

**Register of Deeds Stamp & File Number**

| | Located In: | Corner Code # |
|---|---|---|
| 1. Public Land Survey | T 21N R 15W | K - 5 |
| | T ___ R ___ | |
| | T ___ R ___ | |
| | T ___ R ___ | |
| 2. Property Controlling | S ___ T ___ R ___ | |
| in Section | S ___ T ___ R ___ | |
| 3. Miscellaneous | S ___ T ___ R ___ | |
| *Property in Sec.* | S ___ T ___ R ___ | |

4. Lot No. _____, Recorded Plat _____
5. Private Claims _____

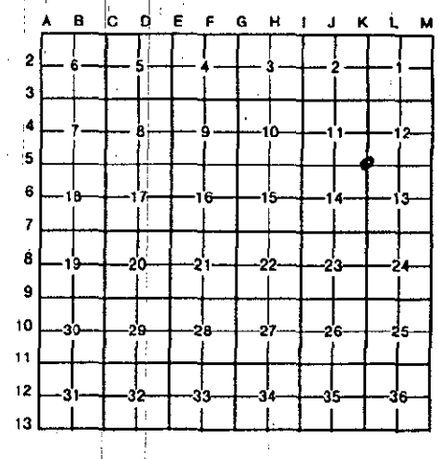


I, Kenneth L Ross, in a field survey on July, 19 94, do hereby certify that under requirements of P.A. 74, Michigan P.A. of 1970, the corner points mentioned in lines 1 and 2 above were in conformance with regulations and rules therefore as required in the current manual of survey instructions of the United States Department of the Interior, Bureau of Land Management or by a decree of a Court of Law and/or that the corner points mentioned in lines 3, 4 and 5 above were in conformance with the rules of the Michigan Board of Land Surveyors or by a Decree of a Court of Law; established, re-established, monumented, re-monumented, recovered, found as expressed below:

**NOTE: Not more than 4 corners, all in the same town and range, may be recorded on this certificate.**

A. *Description of original monument and accessories and/or subsequent restoration:*

K-5 Corner common to sections 11, 12, 13 & 14 T21N, R15W
1837 John Brink D.S., GLO set wood post page 35
40.27 chains north of Indian Reserve line.
1. B. Ash 10" East 22 lks
2. Hemlock 8" S66W 18 lks
1986 K. Ross set corner by double proportinate measurement, set 2"x8' galv. pipe with brass cap
3. carsonite post South 1.0 ft.
4. Hemlock 8" S08E 99.90 ft.
5. Hemlock 8" S30W 95.95 ft.
6. Hemlock 11" S20E 132.44 ft.
7. 2" pipe S20W 106.93 ft.

B. Description of corner evidence found and/or method applied in restoring or reestablishing corner:

K-5 Corner common to sections 11, 12, 13 & 14, T21N, R15W
On July 26, 1994, found 2"x8' galv. pipe with brass cap
Condition of record witnesses are 1. gone 2. gone 3. gone 4 found in good condition 5. found in good condition 6. found in good condition 7. found in good condition

Corner K - 05 ratified by the Manistee County Peer Group according to the county plan adopted pursuant to P.A. 345 of 1990, as amended, (being the State Survey and Remonument Act, MCL 54.261 et. seq.). Date of Peer Review: Bruce P. Simon
ACTING CHAIRMAN **APPROVED** AUG 1 1994

C. Description of monument for corner and accessories established to perpetuate locating the position of the corner:

K-5 Corner common to sections 11, 12, 13 & 14, T21N, R15W
Accepted 2"x8' galv. pipe as substantial monument, and is accepted as a careful & faithful reestablishment of the position of the original corner.
(OBT 4) Hemlock 9" S08E 99.90 ft. (60d nail in SW side)
(OBT 5) Hemlock 9" S16W 95.95 ft. 60d nail in SE side)
(OBT 6) Hemlock 14" S20E 132.44 ft. (60d nail in SW side)
(OBT 7) 2" pipe S20W 106.93 ft.

STATE OF MICHIGAN
KENNETH L. ROSS
LAND SURVEYOR
No. 17634
REGISTERED LAND SURVEYOR

Signed by _____ Date 8-1-94
Surveyor's Michigan License No. 17634

FORM APPROVED BY MICHIGAN STATE BOARD OF LAND SURVEYORS, JAN. 28, 1971
REVISED MAY 14, 1975
REVISED JAN., 1983