

**SURVEY & REMONUMENTATION**

DEC 09 1999

**LAND CORNER RECORDATION CERTIFICATE**

Filing Requirement of Act 74, Mich. P.A. 1970

For corners in  
**MANISTEE**  
(County)

**SECTION**

Located In:

Corner Code #

- 1. Public Land Survey      T 21N R 15W      K-13
- T            R
- T            R
- T            R
- 2. Property Controlling    S            T            R
- in Section                S            T            R
- 3. Miscellaneous            S            T            R
- Property in Sec.         S            T            R
- 4. Lot No. \_\_\_\_\_, Recorded Plat \_\_\_\_\_
- 5. Private Claims \_\_\_\_\_

**REGISTER'S OFFICE  
MANISTEE COUNTY**

99-171 at 4:00 pm  
**MAY 20 1999**

*Deborah Six*  
**REGISTER OF DEEDS**

Register of Deeds Stamp & File Number

I, Richard L. Hays, in a field survey on April 29 1999, do hereby certify that under requirements of P.A. 74, Michigan P.A. of 1970, the corner points mentioned in lines 1 and 2 above were in conformance with regulations and rules therefore as required in the current manual of survey instructions of the United States Department of the Interior, Bureau of Land Management or by a decree of a Court of Law and/or that the corner points mentioned in lines 3, 4 and 5 above were in conformance with the rules of the Michigan Board of Land Surveyors or by a Decree of a Court of Law; established, re-established, monumented, re-monumented, recovered, found as expressed below:

**NOTE: Not more than 4 corners, all in the same town and range, may be recorded on this certificate.**

A. Description of original monument and accessories and/or subsequent restoration:

K-13 Section Corner for Sections 35 & 36, T21N-R15W, on the Township Line

1837, John Brink, G.L.O. boundary survey  
Set Wood post

- #1 Sugar Maple 10" N 14-30" W 24 lks. (15.84')
- #2 Beech 12" N 52 E 22 lks. (14.52')

1971, Robert A. Griffin, RLS #13584

Set 5" by 60" sq. concrete monument with a brass cap at a doubled over distance from the east 1/16 corner, as established by the Plat of "Timber River Ranch", surveyed by Norton and Kobbins in 1961, Griffin double a distance of 1321.34 ft. to the East, as recorded in the plat, Griffin also found a 3/4" Iron Pipe, in which Griffin believes was set in error by Charles Dodt, from undated survey. (see liber 72, pg 30), Note Dodt's pipe in 18.03 ft. South of Griffins location.

- #3 Ash 6" N 88 W 168.53' (10" dock spike in North side of tree)
- #4 White Oak 14" N 48 E 120.65' (10" dock spike in SW side of tree)
- #5 Maple 6" N 84 E 130.26' (10" dock spike in South side of tree)
- #6 Iron Pipe 3/4" South 18.03' (Dodt pipe)
- #7 Treated wood post 4" x 7" North 1.8 ft.

B. Description of corner evidence found and/or method applied in restoring or reestablishing corner:

K-13 Section Corner for Sections 35 & 36, T21N-R15W, on the Township Line

On April 29, 1999, Kevin Pritchard (survey tech) and I found a 5" sq. concrete monument standing one above the surface of the ground, monument as a 3 1/2" brass cap stamped to identify the corner.

CONDITION OF RECORD WITNESSES ARE AS FOLLOWS; #1 Gone #2 Gone #3 Found with top cut off, fair cond.  
#4 Found in good condition #5 Gone #6 Found in good condition #7 Found in good condition

C. Description of monument for corner and accessories established to perpetuate locating the position of the corner:

K-13 Section Corner for Sections 35 & 36, T21N-R15W, on the Township Line


I accepted the 5" concrete monument with brass cap, stamped to identify the corner as a substantial marker for the corner, and is accepted as a careful and faithful re-establishment of the position of the original corner.

- Ext. BT #3 Ash 10" N 88 W 168.53' (found dock spike in North side of tree)
- Ext. BT #4 White Oak 14" N 48 E 120.64' (found dock spike in SW side of tree)
- Ext. BT #6 Iron Pipe 3/4" South 18.08' (Dodt pipe)
- New BT Maple 13" N 08 E 14.87' (set 60d spike in NE side of tree)

Note: Concrete Monument 5" sq. West 40.85' Closing Corner Section 2 and 3, T20N-R15W.

Signed by Richard Hays Date 5/19/99

Surveyor's Michigan License No. 25847

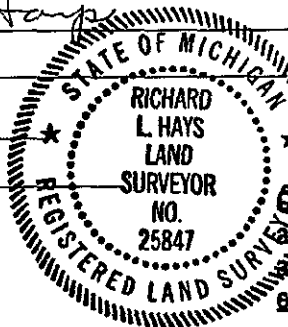

FORM APPROVED BY MICHIGAN STATE BOARD OF LAND SURVEYORS, JAN. 28, 1971  
REVISED MAY 14, 1983

ADAPTED FOR WORD PROCESSING MARCH, 1985

ratified by the Manistee County Peer Group

Super **K-13**  
According to the county plan adopted pursuant to P.A. 345 of 1990, amended, (being the State Survey and Remonument Act, MCL 54.261 et seq.). Date of Peer Review: MAY 04 1999  
*Anthony M. Slawinski*