

LAND CORNER RECORDATION CERTIFICATE

FILING REQUIREMENT OF ACT 74, MICH. P.A.1970

FOR CORNERS OF--:	LOCATED IN--:	CORNER CODE NUMBER
1. PUBLIC LAND SURVEY_____	T. <u>21</u> N. R. <u>16</u> W.	<u>G-8</u>
2. PROPERTY CONTROLLING IN SECTION <u>21</u>	T. <u>21</u> N. R. <u>16</u> W.	<u>10; 14</u>
3. MISCELLANEOUS PROPERTY IN SECTION _____	T. _____ N. S. R. _____ E. W.	_____
4. LOT NO. _____, RECORDED PLAT _____		
5. PRIVATE CLAIMS _____		

REGISTER OF DEEDS STAMP AND FILING NUMBER

I, Carl F. Roser, do hereby certify that under requirements of P.A. 74, Michigan P.A. of 1970, the corner points mentioned in lines 1 and 2 above were, in a field survey on November 3, 1975, established, re-established, monumented, re-monumented, recovered or restored as expressed below and in conformance with regulations and rules therefore as required in the current manual of survey instructions of the United States Department of the Interior, Bureau of Land Management or by a decree of a court of law. Furthermore, that the corner points mentioned in lines 3, 4 and 5 above were, in a field survey on _____, 19____, found, recovered, restored, established or re-established as expressed below and in conformance with the rules of the Michigan State Board of Registration for Land Surveyors or, by a Decree of a Court of law:

A. Description of original monument and accessories and/or subsequent restoration:

B. Description of corner evidence found and/or method applied in restoring or re-establishing corner:

- G-8 Found 1" pipe that fits 1/16 corner & section corner to S. Corner same as used and witnessed by previous RLS's; Stephens, Slawinski & Ross. NOTE: This 1" pipe for 1/4 corner does not fit found 3/4" pipe 1/4 mile N as established by deceased R.L.S. George Johnson.
- 10 Found 3/4" pipe that fits Sec. 21 subdivision by R.L.S. T. Slawinski.
- 14 Found USFS concrete monument which fits previous surveys by R.L.S.'s Stephens & Slawinski.

C. Description of monument for corner and accessories established to perpetuate locating the position of the corner:

G-8	10	14
Fd. 1" pipe & added DNR mon. & 4"x4" post	Found 3/4" pipe & cedar post w/loc. tag	Fd. FS conc. mon. in ctr. N-S rd. NE corner house fd. S60°W 84.1
6" Cherry S50°W 7.5	3" W. Pine S15°W 50.10	SE cor. cemetery set 1/2"x3/8" sq. iron S87°00'E 132.00
Set 7/8"x14" crooked iron pine S86°54'E 41.22	14" Oak N67°W 60.50	4"x4" post w/loc. tag
Set 1 1/2"x18" Iron pin & ced. post N86°29'W 286.65	⊕ Railroad Due N 48'±	Due E 33'


SIGNED BY Carl F. Roser 9-15-76 DATE _____

SURVEYOR'S MICHIGAN REGISTRATION NO. 12028

FOR STATE AND UNITED STATES AGENCIES:

SIGNED BY _____ DATE _____
CHIEF OF SURVEY PARTY

APPROVED AND SIGNED BY _____ DATE _____
MICHIGAN REGISTERED LAND SURVEYOR

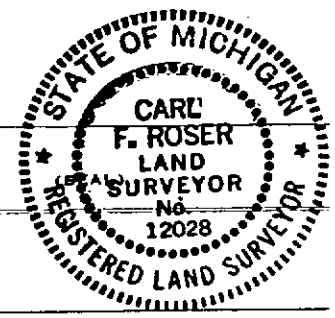

SURVEYOR'S MICHIGAN REGISTRATION NO. _____ STRONACH TOWNSHIP
 MANISTEE COUNTY

MAY PLACE SKETCH ON BACK OR ATTACHED SHEET