

# LAND CORNER RECORDATION CERTIFICATE

FILING REQUIREMENT OF ACT 74, MICH. P.A.1970

FOR CORNERS OF--:	LOCATED IN--:	CORNER CODE NUMBER
1. PUBLIC LAND SURVEY _____	T. 21 <sup>N.</sup> <u>○</u> R. 16 <sup>W.</sup> <u>○</u>	K-9; L-10
2. PROPERTY CONTROLLING IN SECTION 25	T. 21 <sup>N.</sup> <u>○</u> R. 16 <sup>W.</sup> <u>○</u>	1; 9; 14
3. MISCELLANEOUS PROPERTY IN SECTION _____	T. _____ <sup>N.</sup> <u>○</u> R. _____ <sup>E.</sup> <u>○</u>	_____
4. LOT NO. _____, RECORDED PLAT _____		
5. PRIVATE CLAIMS _____		

REGISTER OF DEEDS STAMP AND FILING NUMBER

I, Carl F. Roser do hereby certify that under requirements of P.A. 74, Michigan P.A. of 1970, the corner points mentioned in lines 1 and 2 above (identified with circles on index code diagram - over) were, in a field survey on September 26, 1974, established, re-established, monumented, re-monumented, recovered or restored as expressed below and in conformance with regulations and rules therefore as required in the current manual of survey instructions of the United States Department of the Interior, Bureau of Land Management or by a decree of a court of law. Furthermore, that the corner points mentioned in lines 3, 4 and 5 above were, in a field survey on \_\_\_\_\_ 19\_\_\_\_, found, recovered, restored, established or re-established as expressed below and in conformance with the rules of the Michigan State Board of Registration for Land Surveyors or, by a Decree of a Court of law:

~~A. Description of original monuments and accessories established by subsequent registration.~~

C. (continued)

9	14
Set 1 1/4"x4' pipe & cedar post w/loc. tag	Set 1 1/4"x6' pipe & cedar post w/loc. tag
15" W. Oak N80°W 22.7	15" Hemlock S15°W 17.5
11" R. Oak N55°E 10.6	13" Hemlock S52°W 16.0
1 1/4" pipe S88°40'E 100.03	30" W. Pine N15°W 37.8

B. Description of corner evidence found and/or method applied in restoring or re-establishing corner:

- K-9 Accepted concrete monument as reestablished, witnessed and recorded by RLS Ken Ross.
- L-10 Established corner at intersection of 1/4 lines.
- 1 Established corner per standard B.L.M. instructions.
- 9 Established corner per standard B.L.M. instructions.
- 14 Established corner per standard B.L.M. instructions.

C. Description of monument for corner and accessories established to perpetuate locating the position of the corner:

K-9	L-10	1
Concrete monument	Set DNR mon. & cedar post	Set 1"x5' pipe & cedar post w/loc. tag
6" Twn. Map. N80°W 12.95	11" W. Pine N50°W 46.8	7" Cedar N30°E 19.5
12" Oak S20°E 6.34	3" W. Pine N65°E 26.9	11" Cedar N70°E 11.1
8" Oak N70°E 26.35	6" B. Oak S10°W 14.9	


SIGNED BY \_\_\_\_\_ DATE \_\_\_\_\_

SURVEYOR'S MICHIGAN REGISTRATION NO. 12028

FOR STATE AND UNITED STATES AGENCIES:

SIGNED BY \_\_\_\_\_ DATE \_\_\_\_\_  
CHIEF OF SURVEY PARTY

APPROVED AND SIGNED BY \_\_\_\_\_ DATE \_\_\_\_\_  
MICHIGAN REGISTERED LAND SURVEYOR

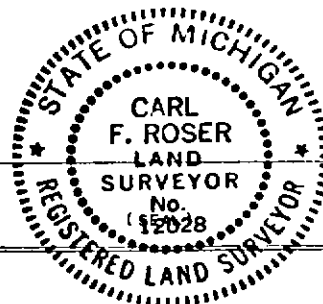

SURVEYOR'S MICHIGAN REGISTRATION NO. \_\_\_\_\_

STRONACH TOWNSHIP  
 MANISTEE COUNTY