

1998 JUN 29 10:09

**SECTION**  
**LAND CORNER RECORDATION CERTIFICATE**  
**Filing Requirement of Act 74, Mich. P.A. 1970**

For corners in

<u>Manistee</u> (County)	Located In:	Corner Code #
1. Public Land Survey	T <u>21N</u> R <u>17W</u>	<u>M-10</u>
	T _____ R _____	<u>East 1/4 Cor.</u>
	T _____ R _____	<u>Sec. 25</u>
	T <u>21N</u> R <u>16W</u>	<u>(A-10) East Filer</u>
2. Property Controlling in Section	S _____ T _____ R _____	_____
	S _____ T _____ R _____	_____
3. Miscellaneous Property in Sec.	S _____ T _____ R _____	_____
	S _____ T _____ R _____	_____
4. Lot No. _____, Recorded Plat _____		
5. Private Claims _____		

**REGISTER'S OFFICE**  
**MANISTEE COUNTY**

98-246 at 9:35 am  
**JUN 29 1998**

*Deborah Six*  
**REGISTER OF DEEDS**

Register of Deeds Stamp & File Number

I, Anthony M. Slawinski, in a field survey on May 20, 19 98 do hereby state that under requirements of P.A. 74, Michigan P.A. of 1970, the corner points mentioned in lines 1 and 2 above were in conformance with regulations and rules therefore as required in the current manual of survey instructions of the United States Department of the Interior, Bureau of Land Management or by a decree of a Court of Law and /or that the corner points mentioned in lines 3, 4 and 5 above were in conformance with the rules of the Michigan Board of Land Surveyors or by a Decree of a Court of Law; established, re-established, monumented, recovered, found as expressed below:

**NOTE: Not more than 2 corners, all in the same town and range, may be recorded on this certificate.**

**A. Description of original monument and accessories and/or subsequent restoration:**

- Set by John Brink in 1837
- Hemlock 10" S 51° W 26 links (Gone)
  - Beech 10" N 28½° W 62 links (Gone)

**B. Description of corner evidence found and/or method applied in restoring or reestablishing corner:**

**Information Referenced:**

- |  |  |
|--|--|
| Michigan Department of Transportation Map 1952, found iron | Survey Certificate by Slawinski (1988) |
| 3. S 45° W 43.25' Fence Post (Gone)                        | Survey Certificate by Slawinski (1991) |
| 4. N 30° E 48.80' Telephone Pole (Gone)                    | Survey Certificate by Slawinski (1997) |
| 5. S 50° E 49.17' Twin 14" Elm & 14" Maple (Gone)          | Survey Certificate by Slawinski (1997) |
| Corner 0.98' East of Construction Centerline               |  |
| U.S. 31 Right of way Map                                   | Survey Certificate by Slawinski (1998) |

On May 20, 1998, I, Anthony Slawinski, along with Abonmarche, found a 7/8" iron rod within a monument box, 1' East of the center line of Highway U.S. - 31.

**C. Description of monument for corner and accessories established to perpetuate locating the position of the corner:**

On May 20, 1998, I installed a Manistee county Monument, within a monument box, in the exact location of the above mentioned 7/8" iron rod, as a careful and faithful re-establishment of the position of the original corner, and witnessed by:


- N 90° W 55.65' Power Pole, 60D spike in the North side
- S 63° W 82.16' 8" Red Pine, 60D spike in the North side
- N 46° E 81.70' Power Pole, 60D spike in the South side
- S 40° E 91.05' Light Pole in Manistee Ford Lot, 60D spike in the North side

Note: Corner is 1' East of the center line of Highway U.S. - 31.  
 South 2652.00 feet to the Southwest Section Corner of Section 25, T21N., R17W.

	A	B	C	D	E	F	G	H	I	J	K	L	M
1													
2	5		5		4		3		2		1		
3													
4	7		8		9		10		11		12		
5													
6	18		17		16		15		14		13		
7													
8	19		20		21		22		23		24		
9													
10	30		29		28		27		26		25		
11													
12	31		32		33		34		35		36		
13													

Corner M-10 ratified by the Manistee County Peer Group according to the county plan adopted pursuant to P.A. 345 of 1990, as amended, (being the State Survey and Reimbursement Act, MCL 54.261 et. seq.) . Date of Peer Review:

JUN 29 1998

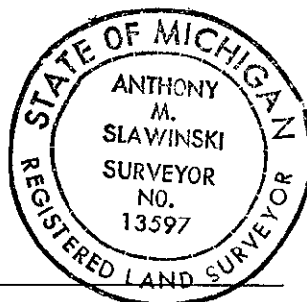

Signed by Anthony M. Slawinski  
 Surveyor's Michigan License No. 13597

Date 6-1-98