

LAND CORNER RECORDATION CERTIFICATE
Filing Requirement of Act 74, Mich. P.A. 1970

For corners in
MANISTEE
 (County)

Located in:

Corner Code #

1. Public Land Survey

T 21N R 17W

E-13

2. Property Controlling
 in Section

S 21N R 17W

E-01

3. Miscellaneous
 Property in Sec.

S T R

4. Lot No. _____, Recorded Plat _____

5. Private Claims _____

REGISTER'S OFFICE
MANISTEE COUNTY
 99-172 at 4:05 pm
MAY 20 1999
Deborah Six
REGISTER OF DEEDS

Register of Deeds Stamp & File Number

I, Richard L. Hays, in a field survey on April 28 19 99, do hereby certify that under requirements of P.A. 74, Michigan P.A. of 1970, the corner points mentioned in lines 1 and 2 above were in conformance with regulations and rules therefore as required in the current manual of survey instructions of the United States Department of the Interior, Bureau of Land Management or by a decree of a Court of Law and/or that the corner points mentioned in lines 3, 4 and 5 above were in conformance with the rules of the Michigan Board of Land Surveyors or by a Decree of a Court of Law; established, re-established, monumented, re-monumented, recovered, found as expressed below:

NOTE: Not more than 4 corners, all in the same town and range, may be recorded on this certificate.

A. Description of original monument and accessories and/or subsequent restoration:
 E-13 Section Corner for Sections 32 & 33, on the South Line of Township.

1839, John Brink, G.L.O. boundary survey
 Set Wood Post at 40 chs.
 #1 Hemlock 30" N 33 E 06 lks. (3.96')
 #2 Hemlock 10" N 45 W 12 lks. (7.92')

1935, State Hwy. WDW (Book A pg. 82)
 Set 4" x 4' Post
 #5 Pine 4" N 56 W 35.80'
 #6 Pine 8" S 62 E 46.00'
 #7 Pine 10" S 18 E 47.00'

1926, John Millard, Manistee Co. Survey
 Monument not given
 #3 White Pine Stump 18" N 42 E 10 lks. (6.6')
 #4 White Pine Stump 36" S 02 E 84 lks. (55.44')
 Book A, pg. 82

1977, Ken Ross, RLS #17634
 Recovered witness from Millard's notes,
 Set 1 1/4" Iron pipe, Found witnesses #3
 #4, #5, #6.
 #8 White Pine 4" N 76 E 44.08'
 #9 White Pine 12" S 66 W 25.87'
 M C 77

B. Description of corner evidence found and/or method applied in restoring or reestablishing corner:
 E-13 Section Corner for Sections 32 & 33, on the South Line of Township.

On April 28, 1999, Kevin Pritchard, surveyor tech., and I found a 1 1/4" Iron Pipe set by Ken Ross in 1977, we also found remains of pine stumps as record by Millard and also found pine tree witness by State Hwy. Dept. records. I found no evidence to dispute this location for the Section corner.


CONDITION OF RECORD WITNESSES ARE AS FOLLOWS; #1 Gone #2 Gone #3 Found White Pine stump
 #4 Found White Pine Stump #5 Found in good condition #6 Found in good condition, Note fd. in SW
 Quadrant
 #7 Found in good condition #8 Found in good condition #9 Found in good condition

C. Description of monument for corner and accessories established to perpetuate locating the position of the corner:
 E-13 Section Corner for Sections 32 & 33, on the South Line of Township.

I replaced 1 1/4" Iron pipe, in the exact location, with a standard MANISTEE COUNTY MONUMENT stamped to identify the corner, I place monument 0.3' above the ground, and is accepted as a careful and faithful re-establishment the position of the original corner.

OBT #5 Red Pine 14" N 56 W 36.70' (ext. 60d spike in NE side of tree)
 OBT #6 Red Pine 14" S 62 E 45.70' (ext. 60d spike in SW side of tree)
 OBT #7 White Pine 16" S 18 W 47.38' (set 60d spike in NW side of tree)
 OBT #8 White Pine 6" N 76 E 44.08' (ext. 60d spike in SE side of tree)
 OBT #9 White Pine 12" S 66 W 25.87' (ext. 60d spike in NW side of tree)

Signed by Richard Hays Date 5/19/99
 Surveyor's Michigan License No. _____

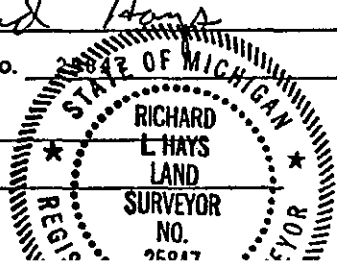

FORM APPROVED BY MICHIGAN STATE BOARD OF LAND SURVEYORS, JAN. 25, REVISED MAY 14.

Corner E-13
 ratified by the Manistee County Peer Group
 according to the county plan adopted pursuant to P.A. 345 of 1990,
 as amended. (bring the State Survey and Department of Natural Resources