

LAND CORNER RECORDATION CERTIFICATE
Filing Requirement of Act 74, Mich. P.A. 1970

For corners in Manistee Located In: _____ Corner Code # _____
 (County)

1. Public Land Survey T 21N R 16W _____ F-13 _____
 T _____ R _____
 T _____ R _____
 T _____ R _____

2. Property Controlling S _____ T _____ R _____
 in Section S _____ T _____ R _____

3. Miscellaneous S _____ T _____ R _____
 Property in Sec. S _____ T _____ R _____

4. Lot No. _____, Recorded Plat _____

5. Private Claims _____

REGISTER'S OFFICE
MANISTEE COUNTY,
 97-182 at 4:30pm
JUN 10 1997
Deborah Six
REGISTER OF DEEDS

Register of Deeds Stamp & File Number

I, Richard L. Hays, in a field survey on April 1997, do hereby certify that under requirements of P.A. 74, Michigan P.A. of 1970, the corner points mentioned in lines 1 and 2 above were in conformance with regulations and rules therefore as required in the current manual of survey instructions of the United States Department of the Interior, Bureau of Land Management or by a decree of a Court of Law and/or that the corner points mentioned in lines 3, 4 and 5 above were in conformance with the rules of the Michigan Board of Land Surveyors or by a Decree of a Court of Law; established, re-established, monumented, re-monumented, recovered, found as expressed below:

NOTE: Not more than 4 corners, all in the same town and range, may be recorded on this certificate.

	A	B	C	D	E	F	G	H	I	J	K	L	M
1													
2	6	5	4	3	2	1							
3													
4	7	8	9	10	11	12							
5													
6	18	17	16	15	14	13							
7													
8	19	20	21	22	23	24							
9													
10	30	29	28	27	26	25							
11													
12	31	32	33	34	35	36							
13													

A. Description of original monument and accessories and/or subsequent restoration:

F-13 SOUTH QUARTER CORNER OF SECTION 33, T21N-R16W

1838: G.L.O Post
 16" Yellow Oak N-57°-E 27 lks (1)
 14" Yellow Pine N-16°-W 58 lks (2)

1972: Robert Griffin #13584, LCRC #73-29
 Set Corner at Proportionate Distance between
 Controlling Corners.

6" Red Pine N-03°-E 63.34' (3)
 3" Maple N-16°-E 28.09' (4)
 5" White Pine N-48°-W 44.48' (5)
 Pine Post West 1.4' (6)

B. Description of corner evidence found and/or method applied in restoring or reestablishing corner:

F-13 SOUTH QUARTER CORNER OF SECTION 33, T21N-R16W

April 1997: Found a 5" Square Concrete Monument, 5' in length with a 3" Stamped Brass Disc, 1.5' above the ground.

Condition of the Witnesses are as follows:

16" Yellow Oak N-57°-E 27 lks (1) GONE
 14" Yellow Pine N-16°-W 58 lks (2) GONE
 6" Red Pine N-03°-E 63.34' (3) FOUND
 3" Maple N-16°-E 28.09' (4) FOUND
 5" White Pine N-48°-W 44.48' (5) FOUND
 Pine Post West 1.4' (6) GONE

**SURVEY &
 REMONUMENTATION**

OCT 14 1997

COMMISSION

Corner E-13 ratified by the Manistee County Peer Group according to the county plan adopted pursuant to P.A. 345 of 1990, as amended, (being the State Survey and Remonument Act, MCL 54.261 et seq.). Date of Peer Review: JUN 3 1997


C. Description of monument for corner and accessories established to perpetuate locating the position of the corner:

F-13 SOUTH QUARTER CORNER OF SECTION 33, T21N-R16W

April 1997: Accepted the 5" Square Concrete Monument, 5' in length with a 3" Stamped Brass Disc, as a careful and faithful re-establishment of the position of the Original Corner.

12" Red Pine N-03°-E 63.38' (3)
 8" Maple N-16°-E 28.14' (4)
 13" White Pine N-48°-W 44.34' (5)
 8" Red Pine S-15°-W 57.63'

This Corner is 107' South of the Centerline of the County Line Road.

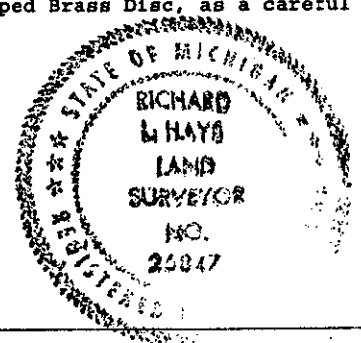

Signed by Richard Hays
 Surveyor's Michigan License No. 25847

Date 5/29/97