

LAND CORNER RECORDATION CERTIFICATE
Filing Requirement of Act 74, Mich. P.A. 1970

For corners in

<u>Manistee</u> (County)	Located In:	Corner Code #
1. Public Land Survey	T21N R 16W	G-7
	T _____ R _____	_____
	T _____ R _____	_____
	T _____ R _____	_____
2. Property Controlling in Section	S _____ T _____ R _____	_____
	S _____ T _____ R _____	_____
3. Miscellaneous Property in Sec.	S _____ T _____ R _____	_____
	S _____ T _____ R _____	_____

REGISTER'S OFFICE
MANISTEE COUNTY

#95-385 AT 11:20 A.M.
OCT 09 1995

Renny A. Pepera
REGISTER OF DEEDS

Register of Deeds Stamp & File Number

4. Lot No. _____, Recorded Plat _____
 5. Private Claims _____

A	B	C	D	E	F	G	H	I	J	K	L	M
2	6	5	4	3	2	1						
3												
4	7	8	9	10	11	12						
5												
6	18	17	16	15	14	13						
7												
8	19	20	21	22	23	24						
9												
10	30	29	28	27	26	25						
11												
12	31	32	33	34	35	36						
13												

Richard Hays, in a field survey on June, 19 95,
 I hereby certify that under requirements of P.A. 74, Michigan P.A. of 1970, the corner points mentioned in lines 1 and 2 above were in conformance with regulations and rules therefore as required in the current manual of survey instructions of the United States Department of the Interior, Bureau of Land Management or by a decree of a Court of Law and/or that the corner points mentioned in lines 3, 4 and 5 above were in conformance with the rules of the Michigan Board of Land Surveyors or by a Decree of a Court of Law; established, re-established, monumented, re-monumented, recovered, found as expressed below:

NOTE: Not more than 4 corners, all in the same town and range, may be recorded on this certificate.

A. Description of original monument and accessories and/or subsequent restoration:

-7 SECTION CORNER COMMON TO SECTIONS 15, 16, 21 & 22

1847:G.L.O. Survey	Kenneth Ross Act 74	Herbert Fluharty Act 74
4" W. Pine S-33'-E 17 Lks	#73-22 Found 1/2" Pipe	#75-27 Fd Large Nail
7" W. Pine N-74 1/2-W 22 Lks	12" B. Oak N-20'-W 46.95'	12" B. Oak N-20'-W 46.95'
	8" B. Oak N-30'-E 50.20'	8" B. Oak N-30'-E 50.20'
Earl Roser	P. Pole S-25'-W 31.00'	P. Pole S-25'-W 31.00'
Act 74 #77-04	Post w/Tag North 33.00'	Post w/Tag North 33.00'
Found 3/8" Spike	Road to the South East 21.00'	Road to the South East 21.00'

B. Description of corner evidence found and/or method applied in restoring or reestablishing corner:

-7 SECTION CORNER COMMON TO SECTIONS 15, 16, 21 & 22


1995:Found 3/8" Spike in blacktop road
 20" B. Oak N-13'-W 46.97'
 18" B. Oak N-30'-E 50.20'
 Road to the South has been rebuilt and the
 Corner is now in the centerline of the road.

Corner 6-07 ratified by the Manistee County Peer Group according to the county plan adopted pursuant to P.A. 345 of 1990, as amended, (being the State Survey and Remonument Act, MCL 54.261 et. seq.). Date of Peer Review: July 5 1995

C. Description of monument for corner and accessories established to perpetuate locating the position of the corner:

-7 SECTION CORNER COMMON TO SECTIONS 15, 16, 21 & 22

1995:Replaced 3/8" Spike with the Standard Manistee County Monument with Brass Cap as the best available evidence of the position of the Original Corner.
 20" B. Oak N-13'-W 46.97'
 18" B. Oak N-30'-E 50.20'
 P. Pole S-52'-W 39.68'
 P. Pole S-21'-E 92.26'
 P. Pole N-54'-E 46.59'

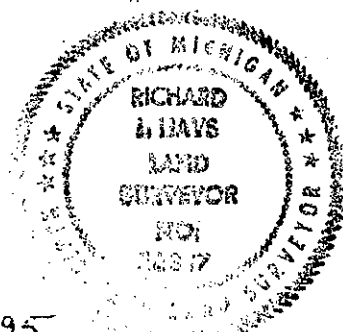

Signed by Richard Hays
 Surveyor's Michigan License No. 25847

Date July 5, 1995