

**LAND CORNER RECORDATION CERTIFICATE**  
**Filing Requirement of Act 74, Mich. P.A. 1970**

For corners in

Manistee

(County)

Located In:

Corner Code #

- |                                       |                           |            |
|---------------------------------------|---------------------------|------------|
| 1. Public Land Survey                 | T <u>21N</u> R <u>16W</u> | <u>G-8</u> |
|                                       | T _____ R _____           | _____      |
|                                       | T _____ R _____           | _____      |
|                                       | T _____ R _____           | _____      |
| 2. Property Controlling<br>in Section | S _____ T _____ R _____   | _____      |
|                                       | S _____ T _____ R _____   | _____      |
| 3. Miscellaneous<br>Property in Sec.  | S _____ T _____ R _____   | _____      |
|                                       | S _____ T _____ R _____   | _____      |
4. Lot No. \_\_\_\_\_, Recorded Plat \_\_\_\_\_
5. Private Claims \_\_\_\_\_

**REGISTER'S OFFICE**  
**MANISTEE COUNTY**

#95-389 AT 1:30 p.m.

OCT 09 1995

*Penny A. Pepora*  
**REGISTER OF DEEDS**

Register of Deeds Stamp & File Number

	A	B	C	D	E	F	G	H	I	J	K	L	M
2	6	5	4	3	2	1							
3													
4	7	8	9	10	11	12							
5													
6	18	17	16	15	14	13							
7													
8	19	20	21	22	23	24							
9													
10	30	29	28	27	26	25							
11													
12	31	32	33	34	35	36							

I, Richard Hays, in a field survey on June, 1995, do hereby certify that under requirements of P.A. 74, Michigan P.A. of 1970, the corner points mentioned in lines 1 and 2 above were in conformance with regulations and rules therefore as required in the current manual of survey instructions of the United States Department of the Interior, Bureau of Land Management or by a decree of a Court of Law and/or that the corner points mentioned in lines 3, 4 and 5 above were in conformance with the rules of the Michigan Board of Land Surveyors or by a Decree of a Court of Law; established, re-established, monumented, re-monumented, recovered, found as expressed below:

**NOTE: Not more than 4 corners, all in the same town and range, may be recorded on this certificate.**

A. Description of original monument and accessories and/or subsequent restoration:

**G-8 QUARTER CORNER COMMON TO SECTIONS 21 & 22**

1847:G.L.O. Survey

1977:Carl Roser

14" W. Pine for Corner on bank of the Little Manistee River.

Found 1" Pipe and set

DNR Monument Act 74 #77-07:

6" Cherry S-50°-W 7.5'

Set 7/8"x14" Crooked Iron

S-68°-54'0E 41.22'

Set 1 1/4"x18" Iron Pin & Post

N-86°-29'-W 286.65'

1932:W.D. Manchester  
 30' South of River in Tag Alders Found Cedar Stake.

B. Description of corner evidence found and/or method applied in restoring or reestablishing corner:

**G-8 QUARTER CORNER COMMON TO SECTIONS 21 & 22**

1995:Found DNR Monument on the banks of the Little Manistee River 28' more or less South of the River.

6" Cherry S-50°-W 7.5'

Crooked Iron S-86°-E 41.22'

Corner G-8 ratified by the Manistee County Peer Group according to the county plan adopted pursuant to P.A. 345 of 1990, as amended, (being the State Survey and Remonument Act, MCL 54.261 et. seq.). Date of Peer Review: July 5 1995

C. Description of monument for corner and accessories established to perpetuate locating the position of the corner:

**G-8 QUARTER CORNER COMMON TO SECTIONS 21 & 22**


1995:Accepted DNR Monument as the best available evidence of the position of the Original Corner.

6" Cherry S-50°-W 7.5'

Crooked Iron S-86°-E 41.22'

13" Ash S-40°-E 78.58'

14" Ash S-63°-E 93.89'

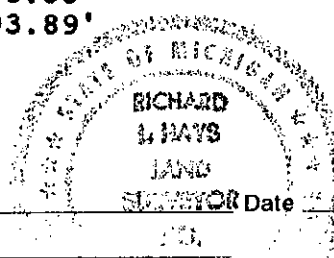

Signed by Richard Hays

Date July 5 1995

Surveyor's Michigan License No. 25847