

**LAND CORNER RECORDATION CERTIFICATE**  
**Filing Requirement of Act 74, Mich. P.A. 1970**

**REGISTER'S OFFICE**  
**MANISTEE COUNTY**  
*#95-387 AT 1:25p.m.*  
**OCT 09 1995**  
*Renny A. Pepera*  
**REGISTER OF DEEDS**

Register of Deeds Stamp & File Number

For corners in Manistee (County) Located In: \_\_\_\_\_ Corner Code # G-9

1. Public Land Survey	T <u>21N</u> R <u>16W</u>	<u>G-9</u>
	T _____ R _____	_____
	T _____ R _____	_____
	T _____ R _____	_____
2. Property Controlling in Section	S _____ T _____ R _____	_____
	S _____ T _____ R _____	_____
3. Miscellaneous Property in Sec.	S _____ T _____ R _____	_____
	S _____ T _____ R _____	_____

4. Lot No. \_\_\_\_\_, Recorded Plat \_\_\_\_\_  
 5. Private Claims \_\_\_\_\_

A	B	C	D	E	F	G	H	I	J	K	L	M
2	6	5	4	3	2	1						
3												
4	7	8	9	10	11	12						
5												
6	18	17	16	15	14	13						
7												
8	19	20	21	22	23	24						
9												
10	30	29	28	27	26	25						
11												
12	31	32	33	34	35	36						
13												

I, Richard Hays, in a field survey on June, 1995, do hereby certify that under requirements of P.A. 74, Michigan P.A. of 1970, the corner points mentioned in lines 1 and 2 above were in conformance with regulations and rules therefore as required in the current manual of survey instructions of the United States Department of the Interior, Bureau of Land Management or by a decree of a Court of Law and/or that the corner points mentioned in lines 3, 4 and 5 above were in conformance with the rules of the Michigan Board of Land Surveyors or by a Decree of a Court of Law; established, re-established, monumented, re-monumented, recovered, found as expressed below:

**NOTE: Not more than 4 corners, all in the same town and range, may be recorded on this certificate.**

**A. Description of original monument and accessories and/or subsequent restoration:**

**G-9 SECTION CORNER COMMON TO SECTIONS 21, 22, 27 & 28**  
 847:G.L.O. SURVEY: Mon. Post 1932:W.D. Manchester-Book A UNDATED NOTES:T. Valliencourt 1967:R. Griffin, Pd. Axel Shaft. Set  
 6" W. Oak S-61°-E 34 Lks Pg 65 Set Car Axle Found Axel Shaft  
 9" W. Oak N-58°-W 18 Lks 14" W. Oak N-71°-E 71.1' Tw. Oak NE 97.17' 5"x3' Conc. Mon. with Brass Disc, Act 74 #73-53  
 18" B. Oak S-46 1/2°-E 62.4' 33" Tw. Oak SE 61.89'  
 18" B. Oak S-39°-W 54.5' 20" Oak NW 85.22' Tw. (10" & 16") B. Oak N-46°-E 97.40'  
 Found Axle Shaft 3" W. Pine S-22°-E 91.17'  
 Fence Corner SE 10.3' 1974:John R. Radcliffe Act 74 #74-15 3" W. Oak S-48°-W 101.50'  
 Sec. Cor. Marker SE 58.8' 1976:Carl F. Roser Act 74 #77-04 20" B. Oak N-29°-W 85.22'  
 1/2" Oak SE 61.6' Post South 33.00'


**B. Description of corner evidence found and/or method applied in restoring or reestablishing corner:**

**G-9 SECTION CORNER COMMON TO SECTIONS 21, 22, 27 & 28**  
 995:Found U.S.F.S. Monument 1.5' below Monument Box in road.  
 6" White Pine S-22°-E 91.17'  
 6" White Oak S-48°-W 101.50'  
 Twin (10" & 16") Black Oak N-46°-E 97.40'

Corner E-21 ratified by the Manistee County Peer Group according to the county plan adopted pursuant to P.A. 345 of 1990, as amended, (being the State Survey and Remonument Act, MCL 54.261 et. seq.), Date of Peer Review: Richard L. Hays  
**JUL 5 1995**

**C. Description of monument for corner and accessories established to perpetuate locating the position of the corner:**

**G-9 SECTION CORNER COMMON TO SECTIONS 21, 22, 27 & 28**  
 Accepted U.S.F.S. Monument, 5" Square, 3' in length with 3" Stamped Brass Disk, as the best available evidence of the position of the Original Corner.  
 Twin (10" & 16") Black Oak N-46°-E 97.40'  
 6" White Pine S-22°-E 91.17'  
 6" White Oak S-48°-W 101.50'  
 24" Black Oak N-29°-W 85.20'  
 Power Pole N-19°-E 101.05'

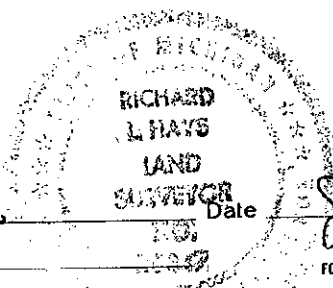

Signed by Richard Hays Date July 5, 1995  
 Surveyor's Michigan License No. 25847