

LAND CORNER RECORDATION CERTIFICATE

Filing Requirement of Act 74, Mich. P.A. 1970

For corners in

Manistee

(County)

Located In:

Corner Code ##

- 1. Public Land Survey T 21N R 16W H-9
 T _____ R _____
 T _____ R _____
 T _____ R _____
- 2. Property Controlling in Section S _____ T _____ R _____
 S _____ T _____ R _____
- 3. Miscellaneous Property in Sec. S _____ T _____ R _____
 S _____ T _____ R _____

**REGISTER'S OFFICE
MANISTEE COUNTY**

#95-391 AT 1:35 p.m.

OCT 09 1995

Penny A. Pepera
REGISTER OF DEEDS

Register of Deeds Stamp & File Number

- 4. Lot No. _____, Recorded Plat _____
- 5. Private Claims _____

	A	B	C	D	E	F	G	H	I	J	K	L	M
2	6	5	4	3	2	1							
3													
4	7	8	9	10	11	12							
5													
6	18	17	16	15	14	13							
7													
8	19	20	21	22	23	24							
9													
10	30	29	28	27	26	25							
11													
12	31	32	33	34	35	36							
13													

Richard Hays, in a field survey on June, 1995

do hereby certify that under requirements of P.A. 74, Michigan P.A. of 1970, the corner points mentioned in lines 1 and 2 above were in conformance with regulations and rules therefore as required in the current manual of survey instructions of the United States Department of the Interior, Bureau of Land Management or by a decree of a Court of Law and/or that the corner points mentioned in lines 3, 4 and 5 above were in conformance with the rules of the Michigan Board of Land Surveyors or by a Decree of a Court of Law; established, re-established, monumented, re-monumented, recovered, found as expressed below:

NOTE: Not more than 4 corners, all in the same town and range, may be recorded on this certificate.

A. Description of original monument and accessories and/or subsequent restoration:

H-9 QUARTER CORNER COMMON TO SECTIONS 22 & 27
 1847:G.L.O. Survey 1976:Carl Roser
 16" W. Pine S-60°-W 6 Lks Restored South Quarter Corner
 30" W. Pine N-08°-E 53 Lks of Section 22. Equal distance
 and on line between the Southwest
 and the Southeast Corners
 Set 1-1/4"x24" Pipe
 6" W. Pine S-35°-W 55.95'
 4" R. Pine S-27°-E 58.10'
 Cedar Post with Tag North 33.00'

B. Description of corner evidence found and/or method applied in restoring or reestablishing corner:

H-9 QUARTER CORNER COMMON TO SECTIONS 22 & 27
 1995:Found the restored 1-1/4"x24" pipe set by Roser and the
 following Witnesses:
 13" B. Oak N-26°-W 61.00'
 14" B. Oak N-58°-E 46.91'
 6" W. Pine S-35°-W 55.95'
 4" R. Pine S-27°-E 58.10'

Corner H-9
 according to the county plan adopted pursuant to P.A. 345 of 1990,
 as amended, (being the State Survey and Remonument Act, MCL 54.261
 et. seq.). Date of Peer Review: October 3, 1995
 ratified by the Manistee County Peer Group


C. Description of monument for corner and accessories established to perpetuate locating the position of the corner:

H-9 QUARTER CORNER COMMON TO SECTIONS 22 & 27
 1995:Replaced 1-1/4"x24" pipe with the Standard Manistee County
 Monument with Brass Cap is accepted as a careful and faithful reestablishment of the
 position of the original corner.

13" B. Oak N-26°-W 61.00'
 14" B. Oak N-58°-E 46.91'
 6" W. Pine S-35°-W 55.95'
 4" R. Pine S-27°-E 58.10'

Signed by Richard Hays

Surveyor's Michigan License No. 25847

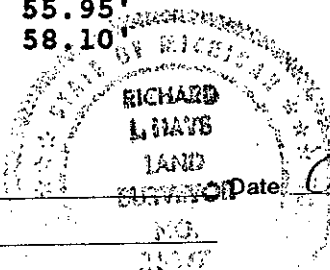

Date: August 10, 1995