

LAND CORNER RECORDATION CERTIFICATE
Filing Requirement of Act 74, Mich. P.A. 1970

For corners in
Manistee
 (County) Located In: _____ Corner Code # _____

1. Public Land Survey T 21N R 16W _____ I-13 _____
 T _____ R _____ _____
 T _____ R _____ _____
 T _____ R _____ _____

2. Property Controlling S _____ T _____ R _____
 in Section S _____ T _____ R _____

3. Miscellaneous S _____ T _____ R _____
 Property in Sec. S _____ T _____ R _____

REGISTER'S OFFICE
MANISTEE COUNTY
 97-185 at 4:30pm
JUN 10 1997
Deborah Six
REGISTER OF DEEDS

Register of Deeds Stamp & File Number

4. Lot No. _____, Recorded Plat _____
 5. Private Claims _____

	A	B	C	D	E	F	G	H	I	J	K	L	M
1													
2	6	5	4	3	2	1							
3													
4	7	8	9	10	11	12							
5													
6	18	17	16	15	14	13							
7													
8	19	20	21	22	23	24							
9													
10	30	29	28	27	26	25							
11													
12	31	32	33	34	35	36							
13													

I, Richard L. Hays, in a field survey on April 1997, do hereby certify that under requirements of P.A. 74, Michigan P.A. of 1970, the corner points mentioned in lines 1 and 2 above were in conformance with regulations and rules therefore as required in the current manual of survey instructions of the United States Department of the Interior, Bureau of Land Management or by a decree of a Court of Law and/or that the corner points mentioned in lines 3, 4 and 5 above were in conformance with the rules of the Michigan Board of Land Surveyors or by a Decree of a Court of Law; established, re-established, monumented, re-monumented, recovered, found as expressed below:

NOTE: Not more than 4 corners, all in the same town and range, may be recorded on this certificate.

A. Description of original monument and accessories and/or subsequent restoration:

I-13 SOUTHEAST CORNER OF SECTION 34, T21N-R16W

1838: G.L.O Post

8" Black Oak N-77°-E 36 lks (1)
 13" Yellow Pine N-45½-W 38 lks (2)

1980: Robert Griffin #13584
 Section Work showing Distances

1972: Robert Griffin #13584, LCRC #73-31
 Set Corner at a Prorated Distance between
 Controlling Corners.

5" White Oak N-04°-W 107.94' (3)
 4" White Oak N-51°-E 9.70' (4)
 Power Pole S-70°-W 94.40' (5)
 13" White Oak N-36°-W 62.65' (6)
 4" Post North 1.40' (7)

B. Description of corner evidence found and/or method applied in restoring or reestablishing corner:

I-13 SOUTHEAST CORNER OF SECTION 34, T21N-R16W

April 1997: Found a 5" Square Concrete Monument, 5' in length with a 3" Stamped Brass Disc, 1.5' above the ground.

Condition of the Witnesses are as follows:

8" Black Oak	N-77°-E	36 lks (1)	GONE
13" Yellow Pine	N-45½-W	38 lks (2)	GONE
5" White Oak	N-04°-W	107.94'	(3) FOUND
4" White Oak	N-51°-E	9.70'	(4) FOUND
Power Pole	S-70°-W	94.40'	(5) FOUND
13" White Oak	N-36°-W	62.65'	(6) FOUND
4" Post	North	1.40'	(7) FOUND

SURVEY &

REMONUMENTATION

OCT 14 1997

COMMISSION

Corner I-13 ratified by the Manistee County Peer Group according to the county plan adopted pursuant to P.A. 345 of 1990, amended, (being the State Survey and Remonument Act, MCL 54.261 et. seq.). Date of Peer Review: JUN 3 1997


C. Description of monument for corner and accessories established to perpetuate locating the position of the corner:

I-13 SOUTHEAST CORNER OF SECTION 34, T21N-R16W

April 1997: Accepted the 5" Square Concrete Monument, 5' in length with a 3" Stamped Brass Disc, as a careful and faithful re-establishment of the position of the Original Corner.

10" White Oak	N-04°-W	108.02'	(3)
11" White Oak	N-51°-E	9.86'	(4)
Power Pole	S-70°-W	94.49'	(5)
20" White Oak	N-36°-W	62.59'	(6)
4" Post	North	1.40'	(7)

Corner is 385' South of the Centerline of the County Line Road.

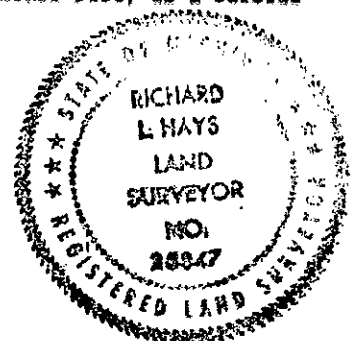

Signed by Richard Hays Date 5/29/97
 Surveyor's Michigan License No. 25847