

LAND CORNER RECORDATION CERTIFICATE

Filing Requirement of Act 74, Mich. P.A. 1970

For corners in Manistee Located In: _____ Corner Code # _____
 (County)

1. Public Land Survey T 21N R 16W _____ J-13
 T _____ R _____
 T _____ R _____
 T _____ R _____

2. Property Controlling S _____ T _____ R _____
 in Section S _____ T _____ R _____

3. Miscellaneous S _____ T _____ R _____
 Property in Sec. S _____ T _____ R _____

4. Lot No. _____ Recorded Plat _____

5. Private Claims _____

REGISTER'S OFFICE
MANISTEE COUNTY
 97-186 at 4:30pm
JUN 10 1997
Reborah Six
REGISTER OF DEEDS

Register of Deeds Stamp & File Number

	A	B	C	D	E	F	G	H	I	J	K	L	M
1													
2	6	5	4	3	2	1							
3													
4	7	8	9	10	11	12							
5													
6	18	17	16	15	14	13							
7													
8	19	20	21	22	23	24							
9													
10	30	29	28	27	26	25							
11													
12	31	32	33	34	35	36							
13													

I, Richard L. Hays, in a field survey on April 1997, do hereby certify that under requirements of P.A. 74, Michigan P.A. of 1970, the corner points mentioned in lines 1 and 2 above were in conformance with regulations and rules therefore as required in the current manual of survey instructions of the United States Department of the Interior, Bureau of Land Management or by a decree of a Court of Law and/or that the corner points mentioned in lines 3, 4 and 5 above were in conformance with the rules of the Michigan Board of Land Surveyors or by a Decree of a Court of Law; established, re-established, monumented, re-monumented, recovered, found as expressed below:

NOTE: Not more than 4 corners, all in the same town and range, may be recorded on this certificate.

A. Description of original monument and accessories and/or subsequent restoration:

J-13 SOUTH QUARTER CORNER OF SECTION 35, T21N-R16W
 1838: G.L.O Post
 16" Yellow Pine N-68°-E 33 lks (1)
 14" Yellow Pine N-24°-W 37 lks (2)

1972: Robert Griffin #13584, LCRC #73-32
 Set Corner at Proportionate Distance between Controlling Corners.
 6" Black Oak N-25°-E 48.92' (3)
 5" Black Oak N-57°-E 51.98' (4)
 10" White Oak N-53°-W 54.07' (5)
 4" Post North 1.72' (6)

B. Description of corner evidence found and/or method applied in restoring or reestablishing corner:

J-13 SOUTH QUARTER CORNER OF SECTION 35, T21N-R16W
 April 1997: Found a 5" Square Concrete Monument, 5' in length with a 3" Stamped Brass Disc, 1.5' above the ground.

Condition of the Witnesses are as follows:

16" Yellow Pine	N-68°-E	33 lks (1)	GONE
14" Yellow Pine	N-24°-W	37 lks (2)	GONE
6" Black Oak	N-25°-E	48.92' (3)	FOUND
5" Black Oak	N-57°-E	51.98' (4)	FOUND
10" White Oak	N-53°-W	54.07' (5)	FOUND
SURVEY & 4" Post	North	1.72' (6)	GONE

REMONUMENTATION

OCT 14 1997

COMMISSION


Corner J-13 ratified by the Manistee County Peer Group according to the county plan adopted pursuant to P.A. 345 of 1990, as amended, (being the State Survey and Remonument Act, MCL 54.261 et. seq.). Date of Peer Review: JUN 3 1997

C. Description of monument for corner and accessories established to perpetuate locating the position of the corner:

J-13 SOUTH QUARTER CORNER OF SECTION 35, T21N-R16W
 April 1997: Accepted the 5" Square Concrete Monument, 5' in length with a 3" Stamped Brass Disc, 1.5' above the ground and faithful re-establishment of the position of the Original Corner.

13" Black Oak	N-25°-E	51.41' (3)
11" Black Oak	N-62°-E	55.72' (4)
12" White Oak	N-49°-W	51.64' (5)
8" Red Pine	S-14°-E	40.08'

Corner is 339' South of the Centerline of the County Line Road.

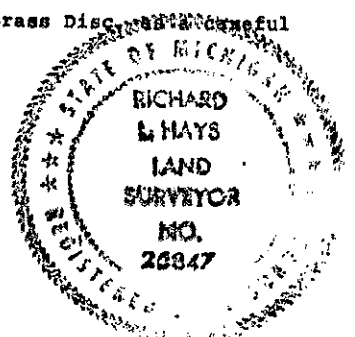

Signed by Richard Hays

Date 5/29/97

Surveyor's Michigan License No. 25847