

LAND CORNER RECORDATION CERTIFICATE
Filing Requirement of Act 74, Mich. P.A. 1970

For corners in _____
Manistee
 (County)

Located In: _____ Corner Code # _____

1. Public Land Survey T 21N R 16W _____
 T _____ R _____
 T _____ R _____
 T _____ R _____

2. Property Controlling S _____ T _____ R _____
 in Section S _____ T _____ R _____

3. Miscellaneous S _____ T _____ R _____
 Property in Sec. S _____ T _____ R _____

4. Lot No. _____, Recorded Plat _____

5. Private Claims _____

REGISTER'S OFFICE
MANISTEE COUNTY
 97-188 at 4:30pm
JUN 10 1997
Deborah Six
REGISTER OF DEEDS

Register of Deeds Stamp & File Number

I, Richard L. Hays, in a field survey on April 1997, do hereby certify that under requirements of P.A. 74, Michigan P.A. of 1970, the corner points mentioned in lines 1 and 2 above were in conformance with regulations and rules therefore as required in the current manual of survey instructions of the United States Department of the Interior, Bureau of Land Management or by a decree of a Court of Law and/or that the corner points mentioned in lines 3, 4 and 5 above were in conformance with the rules of the Michigan Board of Land Surveyors or by a Decree of a Court of Law; established, re-established, monumented, re-monumented, recovered, found as expressed below:

NOTE: Not more than 4 corners, all in the same town and range, may be recorded on this certificate.

	A	B	C	D	E	F	G	H	I	J	K	L	M
1													
2	6	5	4	3	2	1							
3													
4	7	8	9	10	11	12							
5													
6	18	17	16	15	14	13							
7													
8	19	20	21	22	23	24							
9													
10	30	29	28	27	26	25							
11													
12	31	32	33	34	35	36							
13													

A. Description of original monument and accessories and/or subsequent restoration:

L-13 SOUTH 1/4 CORNER OF SECTION 36, T21N-R16W
 1838: G.L.O Post
 10" Yellow Pine N-6 1/2-E 79 lks (1)
 11" Yellow Pine N-66 1/2-W 152 lks (2)

1972: Robert Griffin #13584, LCRC #73-34
 Set Corner at a prorated distance between Controlling Corners.
 6" Red Oak N-67°-E 51.51' (3)
 5" White Oak N-64°-W 36.00' (4)
 7" Red Pine N-38°-W 44.07' (5)
 4" Post North 1.5' (6)

1972: Ross Surveys #17634 Act 132
 Distance from the Southwest Corner to the South 1/4 Corner.

B. Description of corner evidence found and/or method applied in restoring or reestablishing corner:

L-13 SOUTH 1/4 CORNER OF SECTION 36, T21N-R16W
 April 1997: Found a 5" Square Concrete Monument with a 3" Stamped Brass Disc, 1.5' above ground.
 Condition of the Witnesses are:

10" Yellow Pine	N-6 1/2-E	79 lks (1)	GONE
11" Yellow Pine	N-66 1/2-W	152 lks (2)	GONE
6" Red Oak	N-67°-E	51.51' (3)	FOUND
5" White Oak	N-64°-W	36.00' (4)	GONE
7" Red Pine	N-38°-W	44.07' (5)	FOUND
4" Post	North	1.5' (6)	FOUND

SURVEY & REMONUMENTATION

OCT 14 1997

COMMISSION


Corner L-13 ratified by the Manistee County Peer Group according to the county plan adopted pursuant to P.A. 345 of 1990, as amended, (being the State Survey and Remonument Act, MCL 54.261 et. seq.). Date of Peer Review: JUN 9 1997

C. Description of monument for corner and accessories established to perpetuate locating the position of the corner:

L-13 SOUTH 1/4 CORNER OF SECTION 36, T21N-R16W
 April 1997: Accepted 5" square concrete monument with the Stamped 3" Brass Disc as a careful and faithful re-establishment of the position of the Original Corner.

8" Red Oak	N-67°-E	51.54' (3)
14" Red Pine	N-38°-W	44.16' (5)
12" White Oak	N-82°-W	22.48'
7" Jack Pine	S-42°-W	67.43'
4" Post	North	1.40' (6)

Corner is 117' South of the Centerline of County Line Road.

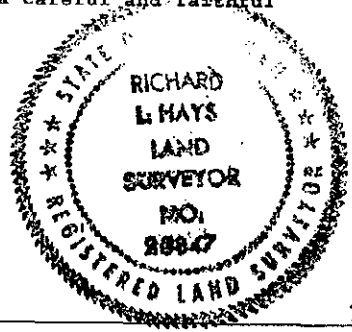

Signed by Richard Hays

Date 5/29/97

Surveyor's Michigan License No. 25847