

SECTION

LAND CORNER RECORDATION CERTIFICATE
Filing Requirement of Act 74, Mich. P.A. 1970

For corners in
MANISTEE
(County)

Located In:

Corner Code #

REGISTER'S OFFICE
MANISTEE COUNTY
#98-340 AT 10:46 A.M.
AUG 17 1998
Penny A. Pepera
REGISTER OF DEEDS

- 1. Public Land Survey T 21 NR 16 W M-9
T 21 NR 15 W A-9
2. Property Controlling in Section S T R
3. Miscellaneous Property in Sec. S T R

Register of Deeds Stamp & File Number

- 4. Lot No. Recorded Plat
5. Private Claims

Grid table with columns A-M and rows 1-13. Contains numbers 1-36 in a grid pattern.

I, Sammy S. Barnett, in a field survey on July 8 19 98, do hereby certify that under requirements of P.A. 74, Michigan P.A. of 1970, the corner points mentioned in lines 1 and 2 above were in conformance with regulations and rules therefore as required in the current manual of survey instructions of the United States Department of the Interior, Bureau of Land Management or by a decree of a Court of Law and/or that the corner points mentioned in lines 3, 4 and 5 above were in conformance with the rules of the Michigan Board of Land Surveyors or by a Decree of a Court of Law; established, re-established, monumented, re-monumented, recovered, found as expressed below;

NOTE: Not more than 4 corners, all in the same town and range, may be recorded on this certificate.

A. Description of original monument and accessories and/or subsequent restoration:

M - 9 Corner common to sections 24 & 25 T21N R16W & 19 & 30 T21N R15W
1837 GLO survey by John Brink, 1949 Sam Walker 1973 K. Ross # 17634 found 3/4" pipe
Set post iron set # 5 Oak 30" S40E 36.52'
1 W. Pine 18" S53W 74 lks No witnesses # 6 Oak 8" West 26.92'
2 W. Pine 20" N73W 34 lks # 7 Oak 10" N10E 53.29'
1908 D. Steels old corner
3 Y. Pine 18" N45E 21 lks
4 W. Pine 30" N73W 34 lks 1974 C. Roser found 3/4" pipe
Witnesses same as K. Ross


B. Description of corner evidence found and/or method applied in restoring or reestablishing corner:

M - 9 Corner common to sections 24 & 25 T21N R16W & 19 & 30 T21N R15W
On July 8th 1998 I found the 3/4" x 40" pipe as found by C. Roser and K. Ross, the condition of the witnesses are as follows.
1 Gone # 2 Gone # 3 Gone # 4 Gone # 5 Found # 6 Found # 7 Found

C. Description of monument for corner and accessories established to perpetuate locating the position of the corner:

M - 9 Corner common to sections 24 & 25 T21N R16W & 19 & 30 T21N R15W
On July 8th 1998 I accepted the found 3/4" pipe as a careful and faithful reestablishment of the position of the original corner and replaced it with a standard Manistee County monument stamped to identify the corner, monument is flush with the ground, and I took the following witnesses.
5 R. Oak 32" S40E 36.52' Found 60d spike in SW side
6 R. Oak 10" West 26.95' Found 60d spike in S side
7 R. Oak 12" N10E 53.30' Found 60d spike in NW side
8 R. Oak 8" N65E 42.85' Set 60d spike in N side

Corner M-09 ratified by the Manistee County Peer Group according to the county plan adopted pursuant to P.A. 345 of 1990, as amended, (being the State Survey and Remonument Act, MCL 54.261 et. seq.). Date of Peer Review: Anthony M. Hawkins AUG 4 1998

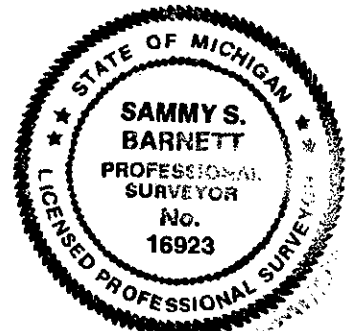

Signed by Sammy S. Barnett Date 8/13/98

Surveyor's Michigan License No. P S # 16923