

SURVEY & REMONUMENTATION
REAR

MAY 13 2000

LAND CORNER RECORDATION CERTIFICATE
Filing Requirement of Act 74, Mich. P.A. 1970

For corners in

<u>Manistee</u> (County)	Located In:	Corner Code #
1. Public Land Survey	T <u>21N</u> R <u>16W</u>	<u>M-13</u>
	T _____ R _____	_____
	T _____ R _____	_____
	T _____ R _____	_____
2. Property Controlling in Section	S _____ T _____ R _____	_____
	S _____ T _____ R _____	_____
3. Miscellaneous S Property in Sec.	T _____ R _____	_____
	S _____ T _____ R _____	_____

SECTION
REGISTER'S OFFICE
MANISTEE COUNTY
97-189 at 4:30pm
JUN 10 1997
Deborah Six
REGISTER OF DEEDS

Register of Deeds Stamp & File Number

4. Lot No. _____, Recorded Plat _____
5. Private Claims _____

	A	B	C	D	E	F	G	H	I	J	K	L	M
1													
2	6	5	4	3	2	1							
3													
4	7	8	9	10	11	12							
5													
6	18	17	16	15	14	13							
7													
8	19	20	21	22	23	24							
9													
10	30	29	28	27	26	25							
11													
12	31	32	33	34	35	36							
13													

I, Richard L. Hays, in a field survey on April 1997, do hereby certify that under requirements of P.A. 74, Michigan P.A. of 1970, the corner points mentioned in lines 1 and 2 above were in conformance with regulations and rules therefore as required in the current manual of survey instructions of the United States Department of the Interior, Bureau of Land Management or by a decree of a Court of Law and/or that the corner points mentioned in lines 3, 4 and 5 above were in conformance with the rules of the Michigan Board of Land Surveyors or by a Decree of a Court of Law; established, re-established, monumented, re-monumented, recovered, found as expressed below:

NOTE: Not more than 4 corners, all in the same town and range, may be recorded on this certificate.

A. Description of original monument and accessories and/or subsequent restoration:

M-13 SOUTHEAST CORNER OF SECTION 36, T21N-R16W
1837: G.L.O Post 1945: Sam Walker Survey "American Box Board Co.
12" Yellow Pine N-50 1/2-W 3.57 lks (1) No Witnesses; Monument set by Walker, is
14" Yellow Pine S-72°-W 4.30 lks (2) S-55°-E 68.15' from the Griffin Monument.

1918: Theodore Norlin Survey 1971: Robert Griffin #13584, LCRC #73-35.
Peg by old Stake. Established Corner from Norlin Notes, and
Witness Tree to the Recovered True Location.
6" White Oak S-30°-W 70.8' (3) 5" Red Pine N-05°-E 62.03' (5)
W-1/4 Section 31 NORTH 2592' (4) 5" Red Pine N-65°-W 104.27' (6)
5" Red Pine N-29°-W 57.08' (7)
4" Dia. Iron Pipe in Concrete S-55°-E 68.15' (8)


B. Description of corner evidence found and/or method applied in restoring or reestablishing corner:

M-13 SOUTHEAST CORNER OF SECTION 36, T21N-R16W
April 1997: Found a 5" Square Concrete USFS Monument, 5' in length with a 3" Stamped Brass Disc.
Condition of the Witnesses are as follows:
12" Yellow Pine N-50 1/2-W 3.57 lks (1) GONE
14" Yellow Pine S-72°-W 4.30 lks (2) GONE
6" White Oak S-30°-W 70.8' (3) GONE
W-1/4 Section 31 NORTH 2592' (4) DID NOT CHECK
5" Red Pine N-05°-E 62.03' (5) FOUND
5" Red Pine N-65°-W 104.27' (6) FOUND
5" Red Pine N-29°-W 57.08' (7) FOUND
4" Dia. Iron Pipe in Concrete S-55°-E 68.15' (8) FOUND

C. Description of monument for corner and accessories established to perpetuate locating the position of the corner:

M-13 SOUTHEAST CORNER OF SECTION 36, T21N-R16W
April 1997: Accepted the 5" Square Concrete USFS Monument, 5' in length with a 3" Stamped Brass Disc, as a careful and faithful perpetuation of the position of the Original Corner.
10" Red Pine N-05°-E 62.03' (5)
4" Dia. Iron Pipe in Concrete S-55°-E 68.15' (8)
7" Red Pine N-29°-W 57.05' (7)
Power Pole S-40°-W 27.77'

Corner is 12' South of the Centerline of County Line Road
Corner M-13 ratified by the Manistee County Peer Group
according to the county plan adopted pursuant to P.A. 345 of 1980,
as amended, (being the State Survey and Remonument Act, MCL 54.261
et. seq.). Date of Peer Review: Anthony M. Haunshel
JUN 3 1997

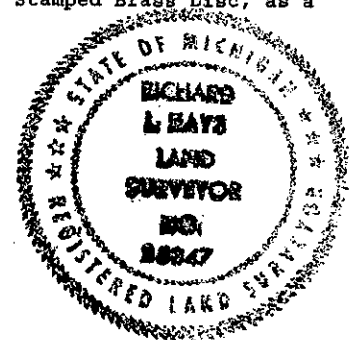

Signed by Richard Hays Date 5/28/97

Surveyor's Michigan License No. 25847